

TATE
J39
6-24-74

MISSISSIPPI
BOARD OF WATER COMMISSIONERS
416 North State Street
Jackson, Mississippi 39201

CODED

WATER WELL DRILLERS LOG

6-24 1974 date well completed
Chick's Bros Well Co. firm name
Tate county well located

LANDOWNER:
Joe Valley - Rt 5
Shelby Springs, Miss.
(mailing address)

description of formations encountered	from	to
Red clay	0	15
Red sand	15	45
white sand	45	105
white sand + clay	105	135
white sand	135	220

WELL LOCATION:
sec. 14 T. 5 N R. 5 E
1 miles (distance) S E of Wyatte (direction) (nearest town)

WELL PURPOSE: home
(home, irrigation, municipal, industrial)

WELL COMPLETION DATA:

(1) diameter (inches) 4 1/2

(2) total depth (feet) 220

(3) static water level (feet) 130 below top of ground

(4) casing Plastic, 220 (material) (depth)

(size) if telescope see back.

(5) screen 4 ft, 216 (length) (depth to top)

4 in, gravel (size) (material)

(6) pump 1/2 (HP) 10 (yield gpm)

Electric 220 (type power)

(7) electric log no (yes or no)

(organization running log)

(8) how well bottom plugged Cap

CODED

MISSISSIPPI WATER WELL DRILLERS ASSOCIATION


AUG - 2 1974

DRILLERS REMARKS:

MISS. BD. OF WATER COMMISSIONERS

If well telescopes please sketch and show depths.

GROUND LEVEL

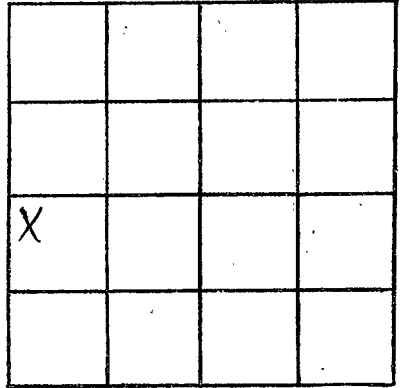

SECTION 14

Please indicate well location X.

ADDITIONAL INFORMATION

If more than one screen, show locations of each on sketch.