

TATE
 J 41
 10-30-74

MISSISSIPPI
 BOARD OF WATER COMMISSIONERS
 416 North State Street
 Jackson, Mississippi 39201

CODED

WATER WELL DRILLERS LOG

10-30 1974 Harris Bros. Fate
 date well completed firm name county well located

LANDOWNER: R. F. Freeman
Rt. 3
Coldwater
 (mailing address)

description of formations encountered	from	to
<u>top soil</u>	<u>0</u>	<u>15</u>
<u>red sand</u>	<u>15</u>	<u>40</u>
<u>clay + sand</u>	<u>40</u>	<u>180</u>
<u>Coarse sand</u>	<u>180</u>	<u>200</u>

WELL LOCATION:
 sec. 17 T 5 N R 5 E ^{15E}
3 1/2 miles NNW of Wentte
 (distance) (direction) (nearest town)

WELL PURPOSE: none
 (home, irrigation, municipal, industrial)

WELL COMPLETION DATA:

(1) diameter (inches) 4

(2) total depth (feet) 200

(3) static water level (feet) 120 ^{below} _{above} top of ground.

(4) casing Plastic, 186,
 (material) (depth)
4 if telescope see back.
 (size)

(5) screen 14, 186
 (length) (depth to top)
008, Plastic
 (size) (material)

(6) pump 3/4, 10
 (HP) (yield gpm)
elec.
 (type power)

(7) electric log no
 (yes or no)

(organization running log)

(8) how well bottom plugged solid

CODED


RECEIVED
 MAR 17 1975

DRILLERS REMARKS:

MISS. BD. OF WATER COMMISSIONERS

If well telescopes please sketch and show depths.

GROUND LEVEL

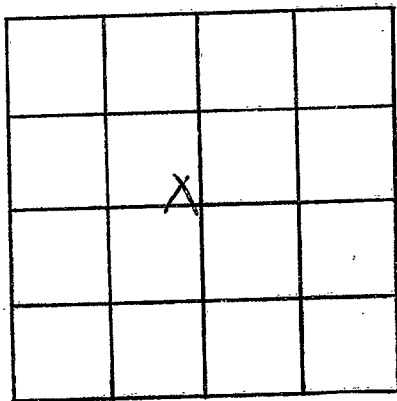

SECTION 17

Please indicate well location X.

ADDITIONAL INFORMATION

If more than one screen,
show locations of each on sketch.