

MISSISSIPPI  
BOARD OF WATER COMMISSIONERS  
416 North State Street  
Jackson, Mississippi 39201

COBEN

WATER WELL DRILLERS LOG

TATE  
J42  
6-28-74

6-28 1974 date well completed  
Harris Bros. firm name  
Tate county well located

LANDOWNER: E. R. Burton  
P.O. # 2  
Coldwater  
(mailing address)


description of formations encountered	from	to
top soil	0	15
red sand	15	40
clay & sand	40	120
coarse sand	120	140

WELL LOCATION:  
sec. 7 T. 5 N R. 5 E  
2 1/2 miles N of Theaters  
(distance) (direction) (nearest town)

WELL PURPOSE: home  
(home, irrigation, municipal, industrial)

- WELL COMPLETION DATA:
- diameter (inches) 4
  - total depth (feet) 140
  - static water level (feet) 80 below top of ground.
  - casing Plastic (material), 123 (depth)  
4 (size) if telescope see back.
  - screen 7 (length), 133 (depth to top)  
208 (size), Plastic (material)
  - pump 3/4 (HP), 7 (yield gpm)  
elec. (type power)
  - electric log no (yes or no)
  - (organization running log)
  - how well bottom plugged solid


DRILLERS REMARKS:

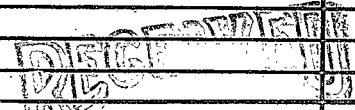

MAR 17 1975

If well telescopes please sketch and show depths.

GROUND LEVEL

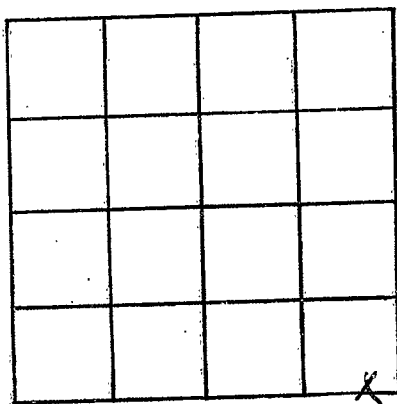

SECTION 7

Please indicate well location X.

ADDITIONAL INFORMATION

If more than one screen, show locations of each on sketch.