

TATE
J 43
3-12-75

MISSISSIPPI
BOARD OF WATER COMMISSIONERS
416 North State Street
Jackson, Mississippi 39201

WATER WELL DRILLERS LOG CODED

3-12 1975 *Sticks Well Co.* *Tate*
date well completed firm name county well located

LANDOWNER: *Tommy Cathey*
Route 1 Box 176
Senatobia, Miss.
(mailing address)

description of formations encountered	from	to
<i>Red Clay</i>	<i>0</i>	<i>15</i>
<i>Red Sand</i>	<i>15</i>	<i>30</i>
<i>White Sand & Clay</i>	<i>60</i>	<i>90</i>
<i>Black Clay</i>	<i>90</i>	<i>150</i>
<i>White Sand</i>	<i>150</i>	<i>170</i>

WELL LOCATION:
sec. *16* T. *5* N. R. *5* E
3 miles *NW* of *Wynette*
(distance) (direction) (nearest town)

WELL PURPOSE: *Domestic*
(home, irrigation, municipal, industrial)

- WELL COMPLETION DATA:
- (1) diameter (inches) *4 in.*
 - (2) total depth (feet) *170*
 - (3) static water level (feet) *150* below above top of ground.
 - (4) casing *Plastic*, *170*,
(material) (depth)
(size) if telescope see back.
 - (5) screen *4 in.*, *16 ft*
(length) (depth to top)
4 in., *Gravel*
(size) (material)
 - (6) pump *1/2*, *10*
(HP) (yield gpm)
Electric 220
(type power)
 - (7) electric log *no*
(yes or no)
 - (8) how well bottom plugged *cap*


DRILLERS REMARKS:

RECEIVED
MAY 23 1975

MISS. BD. OF WATER COM.

If well telescopes please sketch and show depths.

GROUND LEVEL

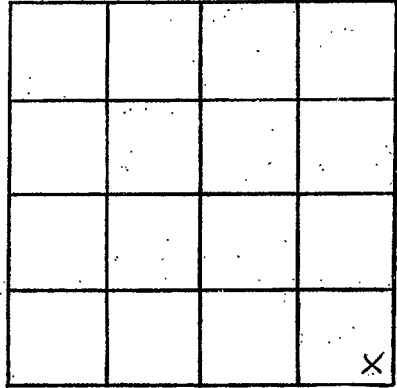

SECTION 16

Please indicate well location X.

ADDITIONAL INFORMATION

If more than one screen, show locations of each on sketch.