

MISSISSIPPI DEPARTMENT OF NATURAL RESOURCES

Bureau of Land and Water Resources

Southport Mall

P.O. Box 10631

Jackson, Mississippi 39209

WATER WELL DRILLERS LOG

CODED  
CODED

TATE  
J47  
4-1-81

21-1 1981 Hicks Well Co. Tate  
date well completed firm name county well located

LANDOWNER: Gold Mewson  
Rt. 5  
Holly Springs, Mo.  
(mailing address)

description of formations encountered	from	to
<u>Red Clay</u>	<u>0</u>	<u>10</u>
<u>Red Sand</u>	<u>10</u>	<u>30</u>
<u>White Sand</u>	<u>30</u>	<u>205</u>


WELL LOCATION:  
sec 24 T 5 N R 5 E  
1 miles E of Wyatte  
(distance) (direction) (nearest town)

WELL PURPOSE: Home  
(home, irrigation, municipal, industrial)

- WELL COMPLETION DATA:
- (1) diameter (inches) 4
  - (2) total depth (feet) 205
  - (3) static water level (feet) 120 below above top of ground.
  - (4) casing PVC, 205  
(material) (depth)
  - (size) if telescope see back.
  - (5) screen 12, 193  
(length) (depth to top)  
4, gravel slotted  
(size) (material)
  - (6) pump 1/2 10  
(HP) (yield gpm)  
220  
(type power)
  - (7) electric log No  
(yes or no)

(organization running log)  
(8) how well bottom plugged Cap

DRILLERS REMARKS:

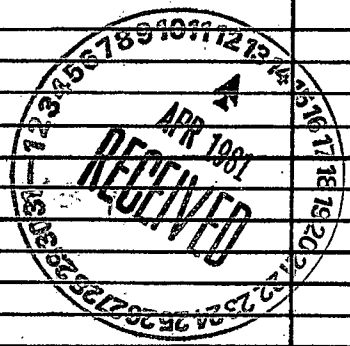

DEPT. OF NATURAL RESOURCES  
BUREAU OF LAND & WATER RESOURCES

APR 13 1981

RECEIVED

If well telescopes please sketch and show depths.

GROUND LEVEL

		X	

SECTION 24

Please indicate well location X.

ADDITIONAL INFORMATION

If more than one screen,  
show locations of each on sketch.