State	Well Report		
	- Driller's Log	For Office Use Only:	
	ent of Environmental Quality	Aquifer:	
	d and Water Resources	Well #: J- 24	
	. Box 10631	Well #:	
Jackson	, MS 39289-0631	L. S. Elevation:	
	)1)961-5210 254 (028 (free)		
(601)	354-6938 (fax)	E-log #:	
State Law requires that this report be prepared by the license holder responsible for the work and filed with the Department at the above address within 30 days of completion of drilling of the well or borehole.			
Information on Well Owner		orehole Location	
(Landowner if borehole is not for a water well)	1 N34. 110.89	W W Longitude: <u>089°43</u> , <u>678</u> "	
Owner Name <u>MS</u> Johnson	Latitude NJY 90 81	$\sum_{i=1}^{n} \text{Longitude:} \frac{\sqrt{67} + 5}{4} \frac{\sqrt{670}}{4}$	
	Method of Lat/Long (circle of	ne): Conventional Survey, 4(	
Mailing Address: 3266 Take Marshall rd.		-	
	USGS quad, Hand-held	GPS, Survey-grade GPS	
t	Swi4NE 1/4 Sec 4	GP3, Survey-grade GPS Twn 55 Rng 5 w	
Coldwater M1 30618 City State Zip Code			
City State Zip Code	Distance Direction	Nearest Town	
Telephone No. (662) 562-7018			
	orehole Data		
Date drilling started: $6 - 3 - 07$ Date drilling completed: $6 - 3$	N-07 Hole depth: 125'	Hole diameter: 6314	
Location of the source of any surface water used for drilling: Method of dosing and volume of Chlorine used in drilling and de	wedopment:		
Logs run (circle all applicable): No log run Electric Gamma R Name of organization running log(s): A	ay Density Sonic Neutron	Other:	
Purpose of borehole (check one): Water Well 🗹 Geotechnical/Geological Investigation Ground Source Heat Pump			
Seismic Survey Other (descr			
If drilling is not related to water well construct	tion, skip the remainder of this bl	lock	
Purpose of Well (check one): Home 🗹 Industrial Public Sur	ply Irrigation Fish Culture	Other:	
If a flowing well, method of flow regulation: ValveA	Other (describe)		
Static Water Level: 33feet above of below (circle one) land surface Date measured: 7-3-07			
Method of Measurement (circle one) steel tape electric tape air line other: String Ineight-			
Well depth: $135$ Well grouted to a depth of <u>10</u> feet Type of grout (circle one): Neat Cement Bentonite Mix			
Casing length: <u>115</u> feet Casing diameter: <u>4</u> inches Type of casing: <u>put</u>			
Screen length: $1^{\circ}$ feet Screen diameter: $-4$ inches Type of screen: $\rho \cup c$			
Screen slot size: <u>OIO</u> inches Setting depth: From			
Type of completion (circle all applicable): Gravel packed Underreamed Telescoped Open hole Natural Development			
Other (describe):			
Top of lap pipe or reduction in casing: feet. If telescoped or more than one screen, describe on next page			

ъ. <sup>4</sup>с

Form: OLWR-SWR-1A

## The sketch below only required for water wells


If well telescopes, show depths on sketch. Ground Level

¢

## Description of formations encountered must be provided for all wells and boreholes, unless specifically exempted by regulations

Description of Formations Encountered	From (depth)	To (depth)
Clay dirt	Ground Level	30
white day	20	35
white soud	35	125
-		

If more than one screen, show location of each on sketch

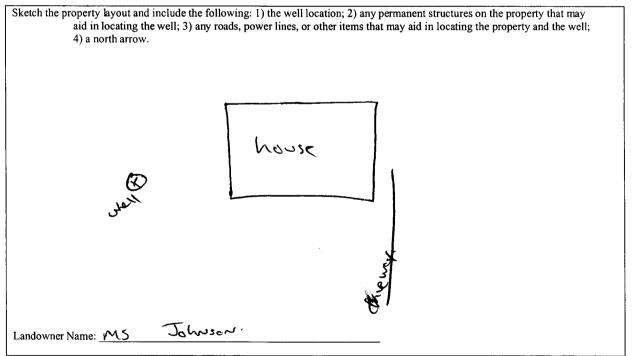

Form: OLWR-SWR-1A

I certify that the well/borehole was drilled, constructed, and completed in accordance with all applicable requirements of the Mississippi Department of Environmental Quality and the Mississippi Department of Health regulations, if applicable, and state

Date

laws. Junes w Moser 0-670 7-24-02

Jans w. Mon Signature of Licensee

Print Name of Responsible Licensee and License No.

	STATE WELL REPORT	
County:	Part 2 Pump Installer's Completion Report	For Office Use Only:
Permit #:	Mississippi Department of Environmental Quality Office of Land and Water Resources	Aquifer:
Driller: Jones u. Meson	P.O. Box 10631	J= JU
Date completed: $7 - 3 - 07$ .	Jackson, MS 39289-0631 (601)961-5210	Well #: 0 - 19
Copy information from block on Part 1	(601)354-6938 (fax)	Elevation:

report must be attached and both parts filed with the Department at the above address within 30 days of well completion.		
Well Owner Information	Well Location	
Owner Name: MS Johnson	Latitude: N34°40, 891 Longitude: 089, 43 676	
Mailing Address: 3266 Take Marshall ral	Method of Lat/Long (check one): Conventional Survey,	

USGS quad\_\_\_\_, Hand-held GPS  $\checkmark$ , Survey-grade GPS\_\_\_\_  $\underline{Sw}$   $\underline{NE}$   $\underline{A}$  Sec  $\underline{4}$   $\underline{T}$   $\underline{5}$   $\underline{S}$   $\underline{R}$   $\underline{5w}$ 

Distance Direction Nearest Town

112 Miles SE of Bett

(alduster	~) -	38518
City	State	Zip Code

Telephone No. (66) 567-7018

Pump Type Circle one		Power Type Circle one			
Air Lift	Jet	Submersible	Diesel Engine	Gasoline Engine	Natural Gas
Bucket	Piston	Turbine	Electric Moto	Hand	Tractor PTO
Centrifugal	Rotary	Flowing Well	Windmill	Other (specify):	
Other (specify):			Horse Power Rating	g of Motor: 3/4	
Date Pump Installed:	7-3-01	<u> </u>	Setting Depth:	50	feet
Rated Pump Capacity:	12	Gallons Per Minute	Number of Stages: _	(1	

Pump Test Data	Method of Measuring Water Level	
Date Well Tested: 7-3-07	Circle one	
Static Water Level (A): <u>33</u> Feet Below Land Surface	Air Line Electric Measuring Line Steel Tape	
	Other (specify): String (meight	
Pumping Water Level (B): Feet Below Land Surface		
Drawdown [(B) – (A)]:Feet Below Land Surface	For flowing well, measured shut in head:feet	
Test Pumping Rate: Gallons Per Minute	Well yielded GPM with a drawdown of	
Duration of Pump Test (minimum 4 hours): <u> </u>	$\underline{\qquad}$ feet after $\underline{\rightarrow} \underline{}$ hours of pumping	

I HEREBY CERTIFY that the above statements are true to the best of my	knowledge.
Jones w-Mason 0-620	Gens we Non
Print Name of Pump Installer and License No. (if applicable)	Signature of Pump Installer
	Earm: OLM/D SM/D 1D

Form: OLWR-SWR-1B