	Stata W	/all Danast		
County: Tote	State Well Report		For Office Use Only:	
County:	Part 1 – Driller's Log Mississippi Department of Environmental Quality		Aquifer:	
Permit #:	Office of Land and Water Resources		Well #: J - 75	
Driller: Jones W. Masan		Box 10631		
Date drilling completed: $10 - 10 - 07$		1S 39289-0631 1961-5210	L. S. Elevation:	
		4-6938 (fax)	E-log #:	
State Law requires that this repor Department at the above address	t be prepared by the lic within 30 days of com	ense holder responsible for t	the work and filed with the	
Information on Well C			rehole Location	
(Landowner if borehole is not fe	Concernation ID		80.45.528	
Owner Name William Do			" Longitude: <u>89°45,588</u> ne): Conventional Survey,	
Mailing Address: 1404 My	Method of Lat/Long (circle or		ne): Conventional Survey,	
	USGS quad, (Hand-held		GPS, Survey-grade GPS	
		SE1 SE 1/ Sec 30	5 Twn 55 Rng 5 W	
<u>Senatchic</u> M City Stat	5. <u>386068</u>	NE NE 31	<u></u>	
		Distance Direction	Nearest Town of Aiken	
Telephone No. (663) 292-184	0-			
	Well / Bore	hale Data		
Well / Borehole Data Date drilling completed: $(0 - (0 - 6))$ Hole depth: $(70)^{6}$ Hole diameter: $(31)^{6}$				
Date drilling started:	illing completed: <u>10-10-</u>	Hole depth: 170	Hole diameter: 6 - 19	
Location of the source of any surface water used for drilling:NA				
Logs run (circle all applicable). No log run Electric Gamma Ray Density Sonic Neutron Other:				
Purpose of borehole (check one): Water W	ell Geotechnical/Geol	ogical Investigation Ground	Source Heat Pump	
	SurveyOther (<i>describe</i> to water well construction)	ock	
Purpose of Well (check one): Home / Industrial Public Supply Irrigation Fish Culture Other:				
Furpose of well (check one): Home \swarrow_{-} in	dustrial Public Supply	Irrigation Fish Culture	Other:	
If a flowing well, method of flow regulatio	n: Valve <u>NA</u> O	ther (describe)		
Static Water Level: 85 feet above or below circle one) land surface Date measured: 10 - 11 - 07				
Method of Measurement (circle one) steel tape electric tape air line other: Acing weight				
Well depth: <u>170</u> Well grouted to a depth of <u>10</u> feet Type of grout (circle one): Neat Cement Bentonite Mix				
Casing length:				
Screen length: $\frac{\partial 0}{\partial c}$ feet Screen diameter: <u>4</u> inches Type of screen: $\underline{\rho \cup c}$				
Screen slot size: \bigcirc (\bigcirc inches Setting depth: From 150 feet to 120 feet				
Type of completion (circle all applicable): Gravel packed Underreamed Telescoped Open hole Natural Development				
Other (describe):				
Top of lap pipe or reduction in casing: <u>A</u> feet. <u>If telescoped or more than one screen, describe on next page</u>				

► ¥₀

Form: OLWR-SWR-1A RECEIVED NOV 15200 BY OLVAR

The sketch below only required for water wells


If well telescopes, show depths on sketch. Ground Level_

<u>ption of formations encountered must be provided for all</u>
nd boreholes, unless specifically exempted by regulations

5-75

Description of Formations Encountered		
clay dirt.	Ground Level	S
red soud	8	45
white clay	45	80
Blue clay	80	140
white soud	140	170
	_	
		1
	1	
	1	1
	.!	I

If more than one screen, show location of each on sketch

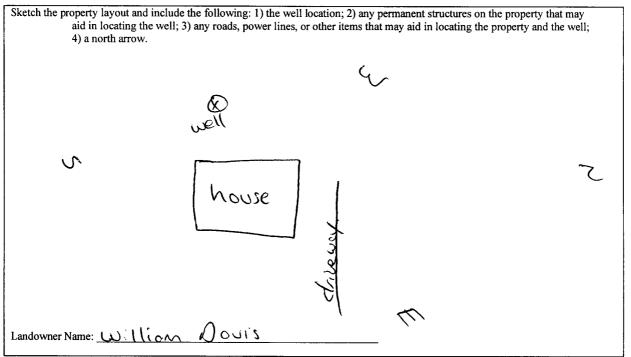

Form: OLWR-SWR-1A

I certify that the well/borehole was drilled, constructed, and completed in accordance with all applicable requirements of the Mississippi Department of Environmental Quality and the Mississippi Department of Health regulations, if applicable, and state

laws. anes w. Majon 0.630 10-7-07 Date

Print Name of Responsible Licensee and License No.

Signature of Licensee

NOVE 1 3 1017 BY: GL. Vie

STATE WELL REPORT				
Permit #: Mississipp Driller: Jacs w. No Serv Date completed: <u>ID-U-07</u> <u>Copy information from block on Part 1</u>	Part 2 p Installer's Completion Report i Department of Environmental Quality ce of Land and Water Resources P.O. Box 10631 Jackson, MS 39289-0631 (601)961-5210 (601)354-6938 (fax) For Office Use Only: Aquifer: Well #: <u>J-75</u> Elevation:			
	water well contractor or a licensed pump installer. A copy of Part 1 of the epartment at the above address within 30 days of well completion. Well Location			
Owner Name: William Douis	Latitude: 34.36.670 Longitude: 89.45.520			
Mailing Address: 1404 hude rd	_			
Se <u>natobia MS 3860</u> City State Zip Co Telephone No. (667) 292-1840	USGS quad, Hand-held GPS_ \checkmark Survey-grade GPS_ $\underline{SE} \ \ \ \ \ \ \ \ \ \ \ \ \ \ \ \ \ \ \$			
Pump Type Circle one	Power Type Circle one			
Air Lift Jet Submersible	e Diesel Engine Gasoline Engine Natural Gas			
Bucket Piston Turbine	Electric Motor Hand Tractor PTO			
Centrifugal Rotary Flowing W				
Other (specify): Date Pump Installed: $1D - 1(- \circ \gamma)$	Horse Power Rating of Motor:			
Rated Pump Capacity: (O Gallons Per	Ŷ			
Pump Test Data	Method of Measuring Water Level			
Date Well Tested: $10 - 11 - 07$ Static Water Level (A): 85 Feet Below Land Pumping Water Level (B): NA Feet Below Land 8	Other (specify): String weight			
Drawdown [(B) – (A)]: Feet Below Land Test Pumping Rate: Gallons Per				
Duration of Pump Test (minimum 4 hours):	hours $\underline{\text{hours of pumping}}$			

•

I HEREBY CERTIFY that the above statements are true to the best	of my knowledge.
Jones W. Moser 0-620	Jers v. Man
Print Name of Pump Installer and License No. (if applicable)	Signature of Pump Instatter
	Form: OLWR-SWR-1B
	NOV 1 3 2007

BY: OLWR