State Well Report				
County: Tote	Part 1 – Driller's Log		For Office Use Only:	
Permit #:	Mississippi Department of Environmental Quality Office of Land and Water Resources		Aquifer:	
Driller: Jose W. Moson	P.O. Box 2309		Well #:	
İ		ı, MS 39225 961- 5210	L. S. Elevation:	
Date drilling completed: 10 - 21-08		I- 5228 (fax)	E-log #:	
State Law requires that this report be prepared by the license holder responsible for the work and filed with the				
Department at the above address within 30 days of completion of drilling of the well or borehole. Information on Well Owner Well or Borehole Location				
(Landowner if borehole is not for a water well)				
Owner Name Dovid Counce		Latitude: 37 30 300	" Longitude: 89 ° 45, 317, 19	
Mailing Address: pogg rd-		Method of Lat/Long (circle on	ne): Conventional Survey,	
between memoris a		USGS quad, fland-held GPS Survey-grade GPS		
		3 W 1/4 N W 1/4 Sec 3 P Twn 5 5 Rng 5 W		
S <u>enotobia</u> <u>Ms</u> City Stat	e Zip Code	Distance Direction	Nearest Town	
Telephone No. (901) 603-5334	-	Distance Direction 118 Miles 5 \(\sigma \)	of thyotica	
700phone 700.				
	Well / Borel	_		
Date drilling started: 10-21-06 Date dri	lling completed: (0-21-0	Hole depth: 155	Hole diameter: 63)4	
Location of the source of any surface water used for drilling: Method of dosing and volume of Chlorine used in drilling and development:				
Logs run (circle all applicable) No log run Electric Gamma Ray Density Sonic Neutron Other: Name of organization running log(s): A				
Purpose of borehole (check one): Water We	ellGeotechnical/Geolo	ogical Investigation Ground	Source Heat Pump	
	urvey Other (<i>describe</i>)			
		, skip the remainder of this blo	ock	
Purpose of Well (check one): HomeIn	dustrial Public Supply	Irrigation Fish Culture _	Other:	
If a flowing well, method of flow regulation	n: ValveOt	her (describe)		
Static Water Level:feet above or below (circle one) land surface Date measured:				
Method of Measurement (circle one) steel tape electric tape air line other: 5+ ring weight				
Well depth: 157 Well grouted to a depth of 10 feet Type of grout (circle one): Neat Cement Bentonite Mix				
Casing length: 145 feet Casing diameter:				
Screen length: 10 feet Screen diameter: 4 inches Type of screen: puc				
Screen slot size: inches Setting depth: From / 47 feet to feet				
Type of completion (circle all applicable): Gravel packed Underreamed Telescoped Open hole Natural Development				
Other (describe):				
Top of lap pipe or reduction in casing: feet. If telescoped or more than one screen, describe on next page				

ŧ,

Form: OLWR-SWR-1A (04/08)

RECEIVED

NOV 2 0 2008

BY OLWR


The sketch below only required for water wells

ij wen tetescopes, snow aept	<u>ns on skeich</u> .
Ground Level	
·	

Description of formations encountered must be provided for all wells and boreholes, unless specifically exempted by regulations

Description of Formations Encountered	From (depth)	To (depth)
Clay dirt.	Ground Level	26
leg sag	26	30
clay dirt.	30	155
		1
	 	
		1
		†
	1	
	<u> </u>	
		
	<u> </u>	
		
		-
		-
	ļ	ļ

If more than one screen, show location of each on sketch

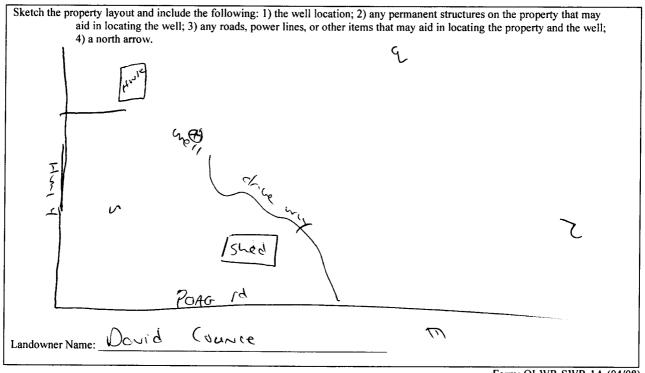

Form: OLWR-SWR-1A (04/08)

I certify that the well/borehole was drilled, constructed, and completed in accordance with all applicable requirements of the Mississippi Department of Environmental Quality and the Mississippi Department of Health regulations, if applicable, and state

Print Name of Responsible Licensee and License No.

Signature of Licensee

NOV 2 0 2008

BY: OLWR

STATE WELL REPORT

County: Tate Permit #: Driller: Jacs w-Mese~ Date completed: 10-22-08 Copy information from block on Part 1 This part of the report must be completed and both part Well Owner Information Owner Name: David (consec

Part 2

Pump Installer's Completion Report Mississippi Department of Environmental Quality

Office of Land and Water Resources
P.O. Box 2309
Jackson, MS 39225
(601)961-5210
(601)961-5228 (fax)

For Office Use Only:		
Aquifer:		
Well #: J-81		
Weil#.		
Elevation:		

This part of the report must be completed by a licensed water well contractor or a licensed pump installer. A copy of Part 1 of the report must be attached and both parts filed with the Department at the above address within 30 days of well completion

report must be attached and both parts filed with the Department at the above address within 30 days of well completion.			
Well Owner Information	Well Location		
Owner Name: Dovid Counce	Latitude: 34.38.300 Longitude: 89.45-317		
Mailing Address: Pacy Cd	Method of Lat/Long (check one): Conventional Survey,		
between Memphis-extended and things. I	USGS quad, Hand-held GPS, Survey-grade GPS		
Senstubia M) 3666 City State Zip Code	5W 1/2 NW 1/4 Sec 20 T 55 R 5W		
ony state Elip code	Distance Direction Nearest Town		
Telephone No. (90) 603-5334	1/8 Miles 5w of thyotica		
Pump Type Circle one	Power Type Circle one		
Air Lift Jet Submersible	Diesel Engine Gasoline Engine Natural Gas		
Bucket Piston Turbine	Electric Motor Hand Tractor PTO		
Centrifugal Rotary Flowing Well	Windmill Other (specify):		
Other (specify):	Horse Power Rating of Motor:3/4		
Date Pump Installed: 10- 22-08	Setting Depth:feet		
Rated Pump Capacity: Gallons Per Minute	Number of Stages: 8		
Pump Test Data	Method of Measuring Water Level Circle one		
Date Well Tested: 10-33-00			
Static Water Level (A): 100 Feet Below Land Surface	Air Line Electric Measuring Line Steel Tape		
Pumping Water Level (B): Feet Below Land Surface	Other (specify): String (weight		
Drawdown [(B) – (A)]: Feet Below Land Surface	For flowing well, measured shut in head:feet		
Test Pumping Rate:(OGallons Per Minute	Well yielded (O GPM with a drawdown of		
Duration of Pump Test (minimum 4 hours):hours	feet after 34 hours of pumping		

I HEREBY CERTIFY that the above statements are true to the best of	of my knowledge.	
Janes W. Mason 0-620	Jan w. Man	
Print Name of Pump Installer and License No. (if applicable)	Signature of Pump Installer	HECEIVEL
	Form: OL	WR-SWR-1B (04/08)

NOV 2 0 2008