

State Well Report

Part 1

Mississippi Department of Environmental Quality

Office of Land and Water Resources

P.O. Box 2309
Jackson, MS 39225

For Office Use Only

Aquifer: J 86

Well #: _____

L.S. Elevation: _____

E-Long #: _____

County: TATE
 Permit #: _____
 Driller: BOB SMITH
 Date drilling complet: 3-29-10

State Law requires that this report be prepared by the driller in detail and filed with the Department within 30 days of completion of drilling of the well.

| Well Owner Information | Well Location |
|--------------------------------------|--|
| Owner Name: <u>ROBERT LOGAN</u> | Latitude: <u>34.36.26</u> " Longitude: <u>89.44.47</u> " |
| Mailing Address: <u>1954 HYDE RD</u> | Method of Lat/Long (circle one): Conventional Survey, USGS quad, Hand-held GPS, Survey-grade GPS |
| <u>SEMAFORA, MS 38668</u> | <u>SW 1/4 NE 1/4 Sec 5-32 Twn 155 Rng 25W</u> |
| City State Zip Code | Distance Direction Nearest Town |
| Telephone No. <u>662 567-9744</u> | <u>3</u> Miles <u>N/W</u> of <u>T410</u> |

Well Data

Purpose of Well (circle one) Home Industrial Public Supply Irrigation Fish Culture Other _____

Date well drilling started: 3-29-10 Date well drilling completed: 3-29-10

If flowing, method of flow regulation: Valve _____ Other (describe) _____

Static Water Level: 115 feet above or below (circle one) land surface Date measured: 4-1-10

Method of Measurement (circle one) steel tape electric tape air line other: LINER WEIGHT

Hole Depth: 230 Well depth: 230 Well grouted to a depth of 10 feet

Type of grout: (circle one): Cement Bentonite Mix _____

Casing length: 220 feet Casing diameter: 4 inches Type of casing: PVC

Screen length: 10 feet Screen diameter: 4 inches Type of screen: PVC

Screen slot size: 13 THOUS inches Setting depth: From 220 feet to 230 feet

Type of completion (circle all applicable):
 Gravel packed Underreamed Telescoped Open hole Natural Development
 Other (describe): _____

Top of lap pipe or reduction incasing: _____ feet. If telescoped or more than one screen, describe on back

Logs run (circle one): No log run Electric Gamma Ray Density Sonic Neutron Other: _____

Name of organization running log(s): _____

I certify that the well drilled, constructed, and completed in accordance with all applicable requirements of the Mississippi Department of Environmental Quality and/or the Mississippi Department of Health regulations and state laws.

Bob Smith 0645
 Print name of Water Contractor and License No. Signature of Water Well Contractor


RECEIVED RECEIVED
 APR 28 2010 APR 28 2010
 BY: OLWR BY: OLWR

Ground Level

586

| Description of Formations Encountered | From | To |
|---------------------------------------|------|-----|
| TOP SOIL | 0 | 8 |
| BROWN CLAY | 8 | 20 |
| WHITE SAND + CLAY | 20 | 160 |
| WHITE SAND | 160 | 230 |
| | | |
| | | |
If more than one screen, show location of each on sketch

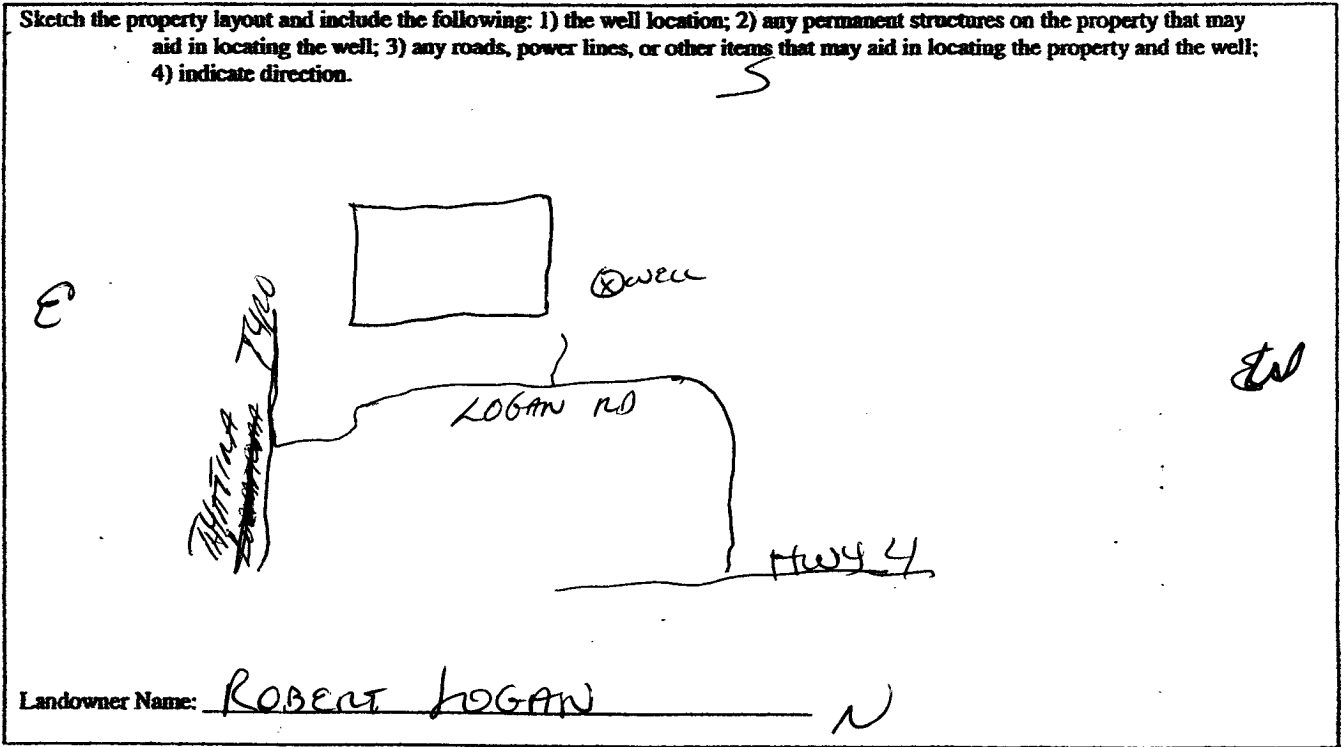


 Signature of Water Well Contractor

RECEIVED
 APR 28 2010
 BY: OLWR

State Well Report
Part 2

Pump Installer's Completion Report
Mississippi Department of Environmental Quality
Office of Land and Water Resources
P.O. Box 2309
Jackson, MS 39225

| | |
|----------------------------|------------|
| For Office Use Only | |
| Aquifer: | <u>586</u> |
| Well #: | _____ |
| Elevation: | _____ |

| | |
|-----------------|------------------|
| County: | <u>TATE</u> |
| Permit #: | _____ |
| Diller: | <u>Bob Smith</u> |
| Date completed: | <u>4-1-10</u> |

This report be prepared by the pump installer in detail and filed with the Department within 30 days of completion of drilling of the well.

| | |
|--------------------------------------|--|
| Well Owner Information | Well Location |
| Owner Name: <u>ROBERT LOGAN</u> | Latitude: _____ Longitude: _____ |
| Mailing Address: <u>1954 HYDE RD</u> | Method of Lat/Long (circle one): <u>Conventional Survey</u> |
| <u>SARMOGA, MS 38668</u> | USGS quad, Hand-held GPS, survey grade GPS |
| City State Zip Code | <u>1/4 1/4 Sec. T-30N R-55 E-1W</u> |
| Telephone No. <u>(662) 562-9744</u> | Distance _____ miles Direction <u>NW</u> Nearest Town of <u>TYCO</u> |

| | |
|--|--|
| Pump Type Circle one | Power Type Circle one |
| Air lift: Jet <input type="checkbox"/> <u>Submersible</u> | Diesel Engine <input type="checkbox"/> Gasoline Engine <input type="checkbox"/> Natural Gas <input type="checkbox"/> |
| Bucket: Piston <input type="checkbox"/> Turbine <input type="checkbox"/> | <u>Electric Motor</u> <input checked="" type="checkbox"/> Hand <input type="checkbox"/> Tractor PTO <input type="checkbox"/> |
| Centrifugal: Rotary <input type="checkbox"/> Flowing Well <input type="checkbox"/> | Windmill <input type="checkbox"/> Other(specify): _____ |
| Other (specify): _____ | Horse Power Rating of Motor: <u>3/4</u> |
| Date Pump Installed: <u>4-1-10</u> | Setting Depth: <u>140</u> feet |
| Rated Pump Capacity: <u>10</u> gallons per min | Number of Stages: <u>11</u> |

| | |
|---|--|
| Pump Test Data | Method of Measuring Water Level circle one |
| Date Well Tested: <u>4-1-10</u> | Air Line <input type="checkbox"/> <u>Electric Measuring Line</u> <input checked="" type="checkbox"/> Steel Tape <input type="checkbox"/> |
| Static Water Level(A): <u>115</u> feet below Land Surface | Other(specify): <u>LINE + WEIGHT</u> |
| Pumping Water Level(B): _____ feet below Land Surface | For flowing well, measured shut in head: _____ feet |
| Drawdown(B)-(A): _____ feet below Land Surface | Well yielded <u>12</u> GPM with a drawdown of _____ feet after _____ hours of pumping |
| Test Pumping Rate: <u>12</u> gallons per minute | |
| Duration of Pump Test (minimum 4 hours): _____ hrs | |

I HEREBY CERTIFY that the above statements are true to the best of my knowledge.

Bob Smith 0645
Print Name of Pump Installer and License No.

[Signature]
Signature of Pump Installer

RECEIVED
APR 28 2010
BY: OLWR