	State W	ell Report	Para Office Hea Only		
County: Tate	Part 1 - Driller's Log		For Office Use Only:		
Permit #:		t of Environmental Quality nd Water Resources	Aquifer:		
Driller. Jones W. Mason	P.O. I	Box 2309	Well #:		
		, MS 39225 961- 5210	L. S. Elevation:		
Date drilling completed: 2-13-12		I- 5228 (fax)	E-log #:		
State Law requires that this report	be prepared by the lice	ense holder responsible for t			
Department at the above address	within 30 days of comp	letion of drilling of the well	or borehole.		
Information on Well O (Landowner if borehole is not for			rehole Location		
` -	·	Latitude: 34.64,988	" Longitude: 89 • 75 , 992" 45 36		
Owner Name William Dovi		39 00 Method of Lat/Long (circle or	ne): Conventional Survey,		
Mailing Address: 175 windin	you e		GPS, Survey-grade GPS		
	·····		Twn 55 Rng 5w		
City State	38618	192	į		
City State	e Zip Code	Distance Direction	Nearest Town of Thyorica		
Telephone No. (62) 292 - 1840	3		or thisting		
	Well / Bore	hole Data			
Date drilling started: 7-13-12 Date dril	lling completed: 7-13-	12 Hole depth: 125	Hole diameter: 63/4		
Location of the source of any surface water	r used for drilling:	NA			
Method of dosing and volume of Chlorine	used in drilling and devel	opment: VA			
Logs run (circle all applicable): No log run Name of organization running log(s):	Electric Gamma Ray	Density Sonic Neutron	Other:		
Purpose of borehole (check one): Water We	ellGeotechnical/Geol	ogical Investigation Ground	I Source Heat Pump		
Seismic S	urveyOther (describe)			
If drilling is not related	to water well constructio	n, skip the remainder of this bl	ock		
Purpose of Well (check one): Home Industrial Public Supply Irrigation Fish Culture Other:					
If a flowing well, method of flow regulation: Valve Other (describe)					
Static Water Level: 37 feet above on below (circle one) land surface Date measured: 7-13-12					
Method of Measurement (circle one) steel tape electric tape air line other: String love ight					
Well depth: 125 Well grouted to a depth of 10 feet Type of grout (circle one): Neat Cement Bentonite Mix					
Casing length: 115 feet Casing diameter: 4 inches Type of casing: psc					
Screen length: 10 feet Screen diameter: 4 inches Type of screen: publications					
Screen slot size: 010 inches Setting depth: From 115 feet to 125 feet					
Type of completion (circle all applicable): Gravel packed Underreamed Telescoped Open hole Natural Development					
Other (describe):					
Top of lap pipe or reduction in casing:ftest. If telescoped or more than one screen, describe on next page					

Form: OLWR-SWFE (1990)


The sketch	below	only	required	for	water	wells

If well telescopes,	show	depths	on	sketch.
Ground Level.		7		

Description of formations encountered must be provided for all wells and boreholes, unless specifically exempted by regulations

Description of Formations Encountered	From (depth)	To (depth)
clay dict	Ground Level	10
red sond	10	30
while soud	30	125

If more than one screen, show location of each on sketch

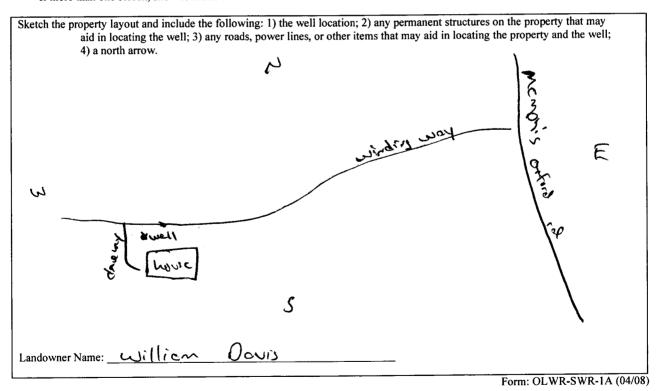

I certify that the well/borehole was drilled, constructed, and completed in accordance with all applicable requirements of the Mississippi Department of Environmental Quality and the Mississippi Department of Health regulations, if applicable, and state laws. cres W. Masor 0-620 8-14-2012 Print Name of Responsible Licensee and License No.

STATE WELL REPORT

Part 2

Pump Installer's Completion Report
Mississippi Department of Environmental Quality
Office of Land and Water Resources
P.O. Box 2309
Jackson, MS 39225
(601)961-5210

For Office Use Only:		
Aquifer:		
Well #:	J93	
Elevation:		

Date completed: 7-13-12

Copy information from block on Part 1

County: Tate

Permit #:

Copy information from block on Part 1	(601)961-5228 (fax)		Elevation.	
This part of the report must be completed report must be attached and both parts file	contractor or a licensed pump in t the above address within 30 da	staller. A copy of Part 1 of the ys of well completion.		
Well Owner Information		Well Location		
Owner Name: william	2110	Latitude: 34 , 64 . 988 Longitude: 89 , 75 . 992		
Mailing Address: 175 wind	poru eni	Method of Lat/Long (check one): Conventional Survey,		
		USGS quad, Hand-held (GPS, Survey-grade GPS	
Coldwaler Ms City State	38618 Zip Code	SW 4NE 4 Sec 18 SE Distance Direction		
Telephone No. (662) 393 - 184	10	MilesN ₩ of	Thyotica	
Pump Type		Pow	ver Type	
Circle one			rcle one	
Air Lift Jet	Submersible	Diesel Engine Gasoline	e Engine Natural Gas	
Bucket Piston	Turbine	Electric Motor Hand	Tractor PTO	
Centrifugal Rotary	Flowing Well		specify):	
Other (specify):		Horse Power Rating of Motor:	3/4	
Date Pump Installed: 7-13-12		Setting Depth:	<u>C</u> feet	
Rated Pump Capacity:	Gallons Per Minute	Number of Stages: 8	,	
Pump Test Data		Method of Mea	suring Water Level	
-			rcle one	
Date Well Tested: 7-13-12		Air Line Electric Meas	uring Line Steel Tape	
Static Water Level (A):Feet Below Land Surface		Other (specify): 5tring lweight		
Pumping Water Level (B): Feet l	Below Land Surface		,	
Drawdown [(B) – (A)]: Feet	Below Land Surface	For flowing well, measured shu	at in head: <u>VA</u> feet	
Test Pumping Rate:(OGallons Per Minute		Well yielded GPM with a drawdown of		
Duration of Pump Test (minimum 4 hours):	<u> Hours</u>	feet after	hours of pumping	
I HEREBY CERTIFY that the above statem	ents are true to the best of	f my knowledge.		

I HEREBY CERTIFY that the above statements are true to the best of my knowledge.

Tokes W. Moso. O-630

Print Name of Pump Installer and License No. (if applicable)

Signature of Pump Installer

Form: OLWR-SWR-1B (04/08)

AUG 1 6 2012 By Oilwa