

TSS
 12 Sw
 220

MISSISSIPPI
 BOARD OF WATER COMMISSIONERS
 416 North State Street
 Jackson, Mississippi 39201

WATER WELL DRILLERS LOG

Tate
 21 2002
 1-67

Jan 27 1967 Thorp Well Supply TATE
 (date well completed) (firm name) (county well located)

LANDOWNER: Bobby Williams
Thytira Miss
Coldwater Miss
 (mailing address)

description of formations encountered	from	to
Top Soil		
Brown Sand	0	15
Red Sand	15	35
" "	35	50
Brown sand & white clay	50	105
white clay	105	130
white clay & sand	130	160
white sand	160	180
Coarse white sand	180	200

WELL LOCATION:
 sec. 20 T. 5 N. R. 5 E.
1/2 miles EAST of Thytira
 (distance) (direction) (nearest town)

WELL PURPOSE: home
 (home, irrigation, municipal, industrial)

WELL COMPLETION DATA:

(1) diameter (inches) 4"

(2) total depth (feet) 199'

(3) static water level (feet) 118 below top of ground


(4) casing Plastic (material), 199 (depth),
4" (size) if telescope see back.

(5) screen 4' (length), 195' (depth to top),
4" (size), Plastic & Sand (PVC) (material)

(6) pump 1/2 (HP), 10 (yield gpm)
230 volts (type power)

(7) electric log No (yes or no)
 (organization running log)

(8) how well bottom plugged 4" cap

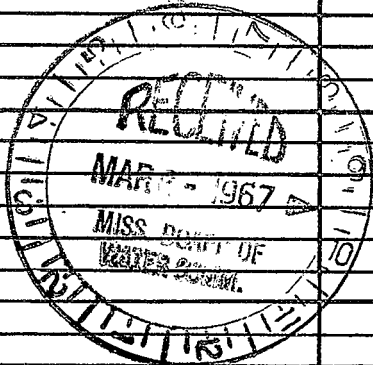

DRILLERS REMARKS:

If well telescopes please sketch and show depths.

GROUND LEVEL

		X	

SECTION 20

Please indicate well location X.

ADDITIONAL INFORMATION

If more than one screen, show locations of each on sketch.