

Late  
J 2004  
10-24-75

MISSISSIPPI  
 BOARD OF WATER COMMISSIONERS  
 416 North State Street  
 Jackson, Mississippi 39201

WATER WELL DRILLERS LOG

10-24 1975 Shubs Well Co. Late  
 date well completed firm name county well located


LANDOWNER:	description of formations encountered	from	to
<u>Billy Davis -</u>	<u>Red Clay + Sand</u>	<u>0</u>	<u>15</u>
<u>Senatobia, Miss.</u> (mailing address)	<u>Red Sand</u>	<u>15</u>	<u>30</u>
WELL LOCATION: sec. <u>13</u> T <u>5</u> N <u>5</u> E R <u>5</u> E <u>15E</u> <u>Wyatte</u> <u>12</u> miles <u>E</u> of <u>Senatobia</u> (distance) (direction) (nearest town)	<u>White Sand</u>	<u>30</u>	<u>170</u>
WELL PURPOSE: <u>drinking</u> (home, irrigation, municipal, industrial)			
WELL COMPLETION DATA:			
(1) diameter (inches) <u>4 1/2</u>			
(2) total depth (feet) <u>170</u>			
(3) static water level (feet) <u>90</u> below top of ground.			
(4) casing <u>Elastic</u> , <u>170</u> , (material) (depth)			
_____ if telescope see back. (size)			
(5) screen <u>7</u> , <u>163</u> (length) (depth to top)			
<u>4 1/2</u> , <u>Gravel</u> (size) (material)			
(6) pump <u>7 1/2</u> , <u>10</u> (HP) (yield gpm)			
<u>230</u> (type power)			
(7) electric log <u>no</u> (yes or no)			
_____ (organization running log)			
(8) how well bottom plugged <u>cap</u>			
DRILLERS REMARKS:			

RECEIVED  
 NOV 13 1975

MISS. BD. OF WATER COMMISSIONERS

If well telescopes please sketch and show depths.

GROUND LEVEL

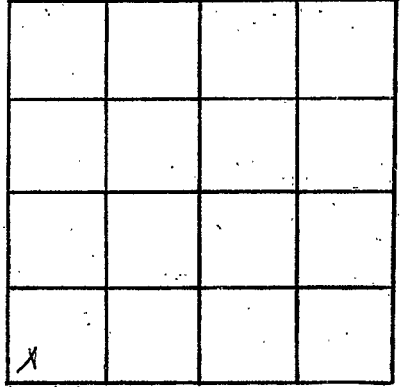

SECTION 13

Please indicate well location X.

ADDITIONAL INFORMATION

If more than one screen, show locations of each on sketch.