

TATE
 J 2005
 2-9-76

MISSISSIPPI
 BOARD OF WATER COMMISSIONERS
 416 North State Street
 Jackson, Mississippi 39201

WATER WELL DRILLERS LOG

2-9-76 19 Hicks well co TATE
 date well completed firm name county well located

LANDOWNER: Terry Pugh
 RT-5 Holly Springs
 (mailing address)

description of formations encountered	from	to
	Red Clay	0
W. S	20	140
Clay & Sand	140	145
White Sand	145	173

WELL LOCATION:
 sec. 4 T 5 N R 5 E
 16 miles East of Senatobia
 (distance) (direction) (nearest town)

WELL PURPOSE: Home
 (home, irrigation, municipal, industrial)

WELL COMPLETION DATA:


(1) diameter (inches) 4"
 (2) total depth (feet) 173
 (3) static water level (feet) 140 below above top of ground.
 (4) casing PVC 173 (material) (depth)
 (size) If telescope see back.
 (5) screen 7' 7' (length) (depth to top)
 (size) (material)
 (6) pump 1/2 10 (HP) (yield gpm)
 220 Elc (type power)
 (7) electric log (yes or no)
 (organization running log)
 (8) how well bottom plugged Cap

DRILLERS REMARKS:

RECEIVED
 FEB 18 1976
 MISS. DD. OF WATER COMM

If well telescopes please sketch and show depths.

GROUND LEVEL

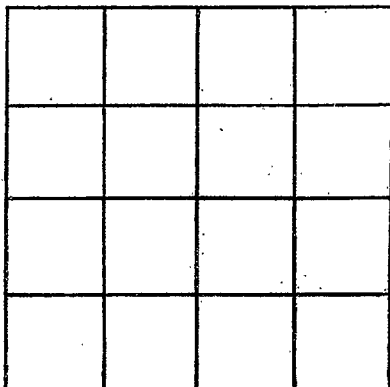

SECTION _____

Please indicate well location X.

ADDITIONAL INFORMATION

If more than one screen, show locations of each on sketch.