

Late  
Jacob  
7-22-76

MISSISSIPPI  
 BOARD OF WATER COMMISSIONERS  
 416 North State Street  
 Jackson, Mississippi 39201

WATER WELL DRILLERS LOG

7-22 <sup>15E</sup> 1976 High Well Co Pate  
 date well completed firm name county well located

LANDOWNER: Tommy Dave  
Senatobia, Miss  
38668  
 (mailing address)

description of formations encountered	from	to
<u>Red Sand + Clay</u>	<u>0</u>	<u>60</u>
<u>White Sand + Clay</u>	<u>60</u>	<u>120</u>
<u>White Sand</u>	<u>120</u>	<u>185</u>

WELL LOCATION:  
 sec 22 T 5 N R 5 E  
1 miles W of Wynette  
 (distance) (direction) (nearest town)

WELL PURPOSE: Home  
 (home, irrigation, municipal, industrial)

- WELL COMPLETION DATA:
- (1) diameter (inches) 4"
  - (2) total depth (feet) 185
  - (3) static water level (feet) 120 below above top of ground.
  - (4) casing PVC 185  
 (material) (depth)
  - (size) If telescope see back.
  - (5) screen 4 ft 181  
 (length) (depth to top)
  - 4 in gravel  
 (size) (material)
  - (6) pump 1/2 10  
 (HP) (yield gpm)
  - 220  
 (type power)
  - (7) electric log NO  
 (yes or no)
  - (organization running log)
  - (8) how well bottom plugged Cap

DRILLERS REMARKS:


**RECEIVED**

AUG 26 1976

MISS. BD. OF WATER COMMISSIONERS

If well telescopes please sketch and show depths.

GROUND LEVEL

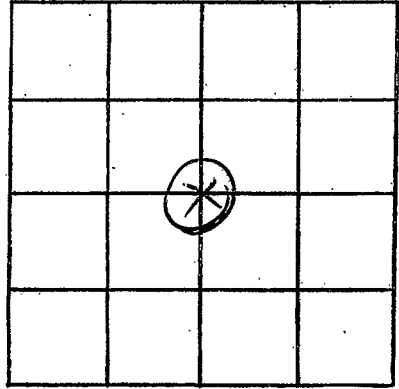

SECTION 22

Please indicate well location X.

ADDITIONAL INFORMATION

If more than one screen, show locations of each on sketch.