

Date
 J 2007
 10-19-76

MISSISSIPPI
 BOARD OF WATER COMMISSIONERS
 416 North State Street
 Jackson, Mississippi 39201

WATER WELL DRILLERS LOG

10-19-76 date well completed
 15E High Well Co. firm name
 State county well located

LANDOWNER: <u>J. V. Buford Sr.</u>	description of formations encountered	from	to
<u>Rt. 2</u>			
<u>Coldwater, Miss</u> (mailing address)	<u>Red Clay</u>	<u>0</u>	<u>20</u>
	<u>Red Sand</u>	<u>20</u>	<u>60</u>
	<u>White Sand</u>	<u>60</u>	<u>100</u>

WELL LOCATION:
 sec. 7 T. 5 N R. 5 E
5 miles SE of Independence
 (distance) (direction) (nearest town)

WELL PURPOSE: None
 (home, irrigation, municipal, industrial)

- WELL COMPLETION DATA:
- (1) diameter (inches) 4
 - (2) total depth (feet) 100
 - (3) static water level (feet) 30 below above top of ground.
 - (4) casing PVC 100
(material) (depth)
 - (size) If telescope see back.
 - (5) screen 4' 96'
(length) (depth to top)
 - 4" Gravel type
(size) (material)
 - (6) pump 3/4 10
(HP) (yield gpm)
 - 220V
(type power)
 - (7) electric log Yes
(yes or no)
 - (organization running log)
 - (8) how well bottom plugged Cap


DRILLERS REMARKS: _____

RECEIVED

JAN 5 1977

If well telescopes please sketch and show depths.

GROUND LEVEL

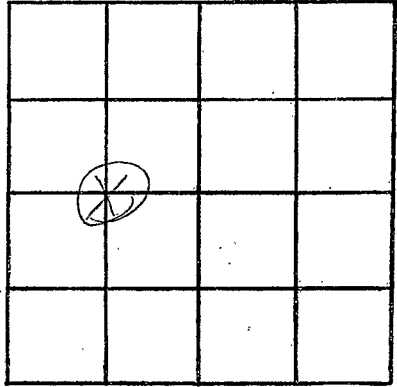

SECTION 2

Please indicate well location X.

ADDITIONAL INFORMATION

If more than one screen, show locations of each on sketch.