

Tate
 J 2009
 12-6-76

MISSISSIPPI
 BOARD OF WATER COMMISSIONERS
 416 North State Street
 Jackson, Mississippi 39201

WATER WELL DRILLERS LOG

12-6-76 date well completed
 15E Hickwell Co. firm name
 Tate county well located


LANDOWNER: <u>See Chester Drive Rt. 2</u>	description of formations encountered	from	to
<u>Coldwater</u> (mailing address)	<u>Clay</u>	<u>0</u>	<u>40</u>
	<u>Clay & sand</u>	<u>40</u>	<u>80</u>
	<u>White sand</u>	<u>80</u>	<u>95</u>
WELL LOCATION:			
sec. <u>1</u> T. <u>5</u> N. R. <u>6</u> E.			
<u>4</u> miles <u>SE</u> of <u>Independence</u>			
WELL PURPOSE: <u>None</u> (home, irrigation, municipal, industrial)			
WELL COMPLETION DATA:			
(1) diameter (inches) <u>4</u>			
(2) total depth (feet) <u>95</u>			
(3) static water level (feet) <u>40</u> below above top of ground.			
(4) casing <u>PVC</u> <u>95</u> (material) (depth)			
(size) If telescope see back.			
(5) screen <u>7'</u> <u>88'</u> (length) (depth to top)			
<u>4 1/4</u> <u>Crane Pipe</u> (size) (material)			
(6) pump <u>1/2</u> <u>10</u> (HP) (yield gpm)			
<u>220V</u> (type power)			
(7) electric log <u>No</u> (yes or no)			
(organization running log)			
(8) how well bottom plugged <u>Cap</u>			
DRILLERS REMARKS:			

RECEIVED
 JAN 2 1977

MISS. BD. OF WATER COMMISSIONERS

If well telescopes please sketch and show depths.

GROUND LEVEL

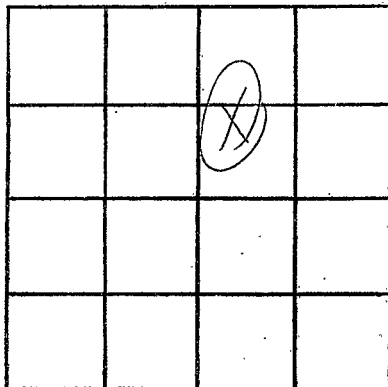

SECTION 1

Please indicate well location X.

ADDITIONAL INFORMATION

If more than one screen, show locations of each on sketch.