

Date
 J 2010
 4-6-77

MISSISSIPPI
 BOARD OF WATER COMMISSIONERS
 416 North State Street
 Jackson, Mississippi 39201

WATER WELL DRILLERS LOG

4-6 1977 *Hicks Well Co.* *Tate*
 date well completed firm name county well located

LANDOWNER: *E. C. Thompson*
(Pt. 1)

Senatobia, Ms. 38668
 (mailing address)

| description of formations encountered | from | to |
|---------------------------------------|------------|------------|
| <i>Red Clay</i> | <i>0</i> | <i>10</i> |
| <i>Red Sand</i> | <i>10</i> | <i>100</i> |
| <i>White Sand</i> | <i>100</i> | <i>170</i> |

WELL LOCATION:
 sec. *29* T. *5* N. R. *5* E.
1 miles *S* of *Thattin*
 (distance) (direction) (nearest town)

WELL PURPOSE: *Home*
 (home, irrigation, municipal, industrial)

- WELL COMPLETION DATA:
- (1) diameter (inches) *4*
 - (2) total depth (feet) *170*
 - (3) static water level (feet) *120* below above top of ground.
 - (4) casing *PVC*, *170*,
 (material) (depth)
 (size) if telescope see back.
 - (5) screen *4'*, *166'*
 (length) (depth to top)
4" gravel type
 (size) (material)
 - (6) pump *3/4*, *10*
 (HP) (yield gpm)
220V
 (type power)
 - (7) electric log *No*
 (yes or no)


(organization running log)
 (8) how well bottom plugged *Cap*

DRILLERS REMARKS:

RECEIVED
 MAY 13 1977

If well telescopes please sketch and show depths.

GROUND LEVEL

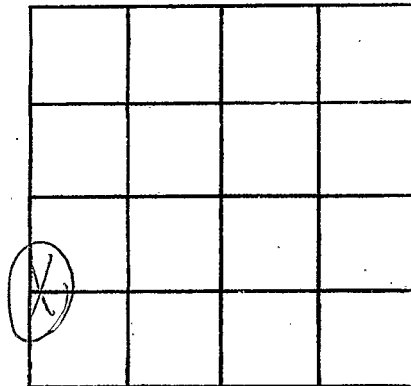

SECTION 29

Please indicate well location X.

ADDITIONAL INFORMATION

If more than one screen, show locations of each on sketch.