

TATE  
J 2011  
4-28-77

MISSISSIPPI  
BOARD OF WATER COMMISSIONERS  
416 North State Street  
156 Jackson, Mississippi 39201

WATER WELL DRILLERS LOG

4-28 1977 Hick Well Co. Tate  
date well completed firm name county well located

LANDOWNER: <u>Mr. W. T. Freeman</u>	description of formations encountered	from	to
<u>Pl. 1</u>			
<u>Senatobia, Ms.</u> (mailing address)	<u>Red Clay</u>	<u>0</u>	<u>10</u>
	<u>Red Clay &amp; sand</u>	<u>10</u>	<u>45</u>
	<u>White sand</u>	<u>45</u>	<u>127</u>

WELL LOCATION:  
sec. 1 T. 5 N. R. 5 E  
17 miles E of Senatobia  
(distance) (direction) (nearest town)

WELL PURPOSE: Home  
(home, irrigation, municipal, industrial)

- WELL COMPLETION DATA:
- (1) diameter (inches) 4
  - (2) total depth (feet) 127
  - (3) static water level (feet) 45 below above top of ground.
  - (4) casing PVC, 127,  
(material) (depth)  
(size) if telescope see back.
  - (5) screen 4', 123'  
(length) (depth to top)  
4" gravel type  
(size) (material)
  - (6) pump 1/2, 10  
(HP) (yield gpm).  
220V  
(type power)
  - (7) electric log No  
(yes or no)

(organization running log)  
(8) how well bottom plugged Cap


DRILLERS REMARKS:

RECEIVED  
MAY 13 1977

MISS. Bd. OF WATER COMMISSIONERS

If well telescopes please sketch and show depths.

GROUND LEVEL

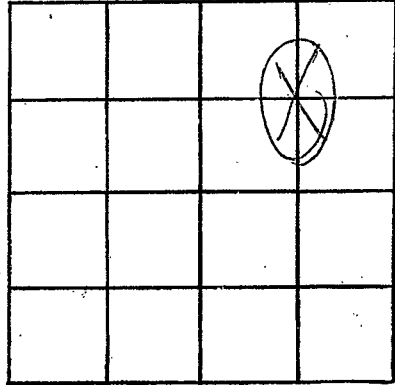

SECTION 1

Please indicate well location X:

ADDITIONAL INFORMATION

If more than one screen,  
show locations of each on sketch.