

Date
 J 2012
 8-3-77

MISSISSIPPI
 BOARD OF WATER COMMISSIONERS
 416 North State Street
 15E Jackson, Mississippi 39201

WATER WELL DRILLERS LOG

8-3-77 19 date well completed
 Hicks Well Co firm name
 TATE county well located

LANDOWNER: Billy White
RT. 2 Coldwater
Miss.
 (mailing address)

description of formations encountered	from	to
RC	0	15
R SAND	15	30
RS - CRAP	30	60
W.S.	60	127

WELL LOCATION:
 sec. 6 T S N R 5 E
 (S) (W)
1/2 miles S of Bett
 (distance) (direction) (nearest town)

WELL PURPOSE: Home
 (home, irrigation, municipal, industrial)

WELL COMPLETION DATA:

(1) diameter (inches) 4

(2) total depth (feet) 127

(3) static water level (feet) 40 below top of ground.

(4) casing PVC, 120,
 (material) (depth)
 (size) if telescope see back.

(5) screen 7', 7'
 (length) (depth to top)
4, inside rock
 (size) (material)

(6) pump 1/2, 10
 (HP) (yield gpm)
Elect
 (type power)

(7) electric log
 (yes or no)

 (organization running log)

(8) how well bottom plugged cap


DRILLERS REMARKS:

RECEIVED
 AUG 13 1977

MISS. BD. OF WATER CONTN

If well telescopes please sketch and show depths.

GROUND LEVEL

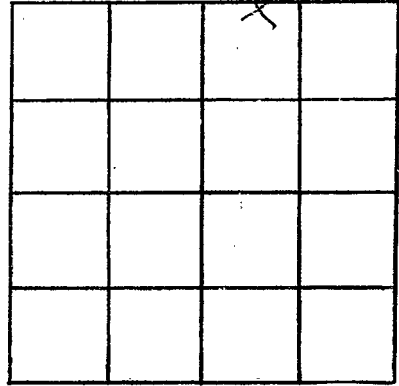

SECTION _____

Please indicate well location X.

ADDITIONAL INFORMATION

If more than one screen, show locations of each on sketch.