

Date
 J 2013
 8-18-77

MISSISSIPPI
 BOARD OF WATER COMMISSIONERS
 416 North State Street
 Jackson, Mississippi 39201

WATER WELL DRILLERS LOG

8/18/77 date well completed
 Klinks Well Co firm name
 Tate county well located

LANDOWNER: Jetson Lewerson
 (Pt.)
Senatobia, Ms.
 (mailing address)

description of formations encountered	from	to
Red clay	0	40
White c. clay & sand	40	120
White sand	120	150

WELL LOCATION:
 sec. 32 5 N 5 E
2 miles S of Thurston
 (distance) (direction) (nearest town)

WELL PURPOSE: Home
 (home, irrigation, municipal, industrial)

WELL COMPLETION DATA:

(1) diameter (inches) 4

(2) total depth (feet) 150

(3) static water level (feet) 80 below above top of ground.

(4) casing PVC, 150
 (material) (depth)
 (size) if telescope see back.

(5) screen 7', 143
 (length) (depth to top)
4", gravel type
 (size) (material)

(6) pump 42 10
 (HP) (yield gpm)
220V
 (type power)

(7) electric log No
 (yes or no)

(organization running log)

(8) how well bottom plugged. Cap


RECEIVED
 OCT 17 1977

DRILLERS REMARKS:

MISS. BD. OF WATER COMM.

If well telescopes please sketch and show depths.

GROUND LEVEL

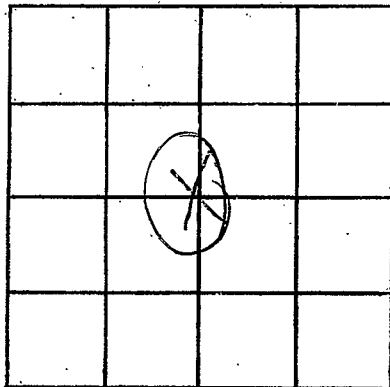

SECTION 32

Please indicate well location X.

ADDITIONAL INFORMATION

If more than one screen, show locations of each on sketch.