

Tate
 J 2014
 10/5/77

MISSISSIPPI
 BOARD OF WATER COMMISSIONERS
 416 North State Street
 15E Jackson, Mississippi 39201

WATER WELL DRILLERS LOG

10-5-77 date well completed
 Hickwell Co. firm name
 Tate county well located

LANDOWNER: North West
Child Care Center -
Upa Center - Senatobia
 (mailing address)

description of formations encountered	from	to
Red Clay	0	20
Red Clay + Sand	20	60
Red Sand	60	140
Red Sand + Clay	140	168
White Sand	160	174

WELL LOCATION:
 sec. 33 T 5 N R 5 E
2 miles S of Thattus
 (distance) (direction) (nearest town)

WELL PURPOSE: school
 (home, irrigation, municipal, industrial)

- WELL COMPLETION DATA:
- (1) diameter (inches) 4
 - (2) total depth (feet) 174
 - (3) static water level (feet) 110 below above top of ground.
 - (4) casing PVC, 174,
 (material) (depth)
 (size) if telescope see back.
 - (5) screen 7', 167
 (length) (depth to top)
4", gravel type
 (size) (material)
 - (6) pump 1 1/2, 18
 (HP) (yield gpm)
220V
 (type power)
 - (7) electric log No
 (yes or no)
 (organization running log)
 - (8) how well bottom plugged Cap

DRILLERS REMARKS:


RECEIVED

OCT 17 1977

MISS. BD. OF WATER COMM

If well telescopes please sketch and show depths.

GROUND LEVEL

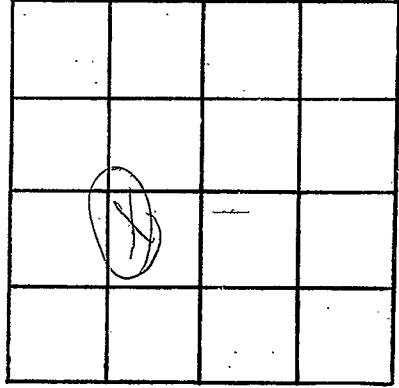

SECTION 33

Please indicate well location X.

ADDITIONAL INFORMATION

Lined area for additional information.

If more than one screen, show locations of each on sketch.