

TATE
 J 2015
 2/11/78

MISSISSIPPI
 BOARD OF WATER COMMISSIONERS
 416 North State Street
 Jackson, Mississippi 39201

WATER WELL DRILLERS LOG

2-11 1978 Hick Well Co. Tate
 date well completed firm name county well located

LANDOWNER: Sam Crockett
Rt. 2
Coldwater, Ms.
 (mailing address)

description of formations encountered	from	to
<u>Red Clay</u>	<u>0</u>	<u>20</u>
<u>Red Clay & Sand</u>	<u>20</u>	<u>60</u>
<u>White Clay & Sand</u>	<u>60</u>	<u>180</u>
<u>White Sand</u>	<u>180</u>	<u>168</u>

WELL LOCATION:
 sec. 19 T. 5 N. R. 5 E.
1/2 miles W of Tipton
 (distance) (direction) (nearest town)

WELL PURPOSE: Home
 (home, irrigation, municipal, industrial)


WELL COMPLETION DATA:
 (1) diameter (inches) 4"
 (2) total depth (feet) 168"
 (3) static water level (feet) 130 below above top of ground.
 (4) casing PVC 168
 (material) (depth)
 (size) if telescope see back.
 (5) screen 7' 161"
 (length) (depth to top)
4" gravel type
 (size) (material)
 (6) pump 1/2 10'
 (HP) (yield gpm)
2200
 (type power)
 (7) electric log Lo
 (yes or no)
 (organization running log)
 (8) how well bottom plugged Cap

DRILLERS REMARKS:

RECEIVED
 FEB 27 1978

If well telescopes please sketch and show depths.

GROUND LEVEL

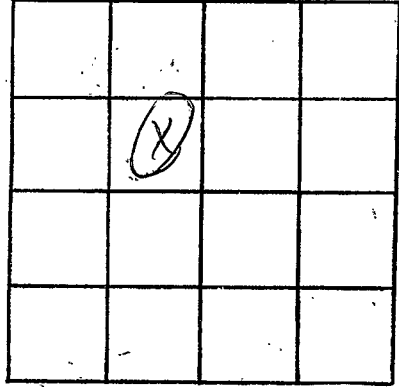

SECTION 19

Please indicate well location X.

ADDITIONAL INFORMATION

If more than one screen, show locations of each on sketch.