

TATE
J 2016

**MISSISSIPPI  
BOARD OF WATER COMMISSIONERS**  
416 North State Street  
Jackson, Mississippi 39201

**WATER WELL DRILLERS LOG**

7-31-1978 Hicks Well Co Tate  
 date well completed firm name county well located

LANDOWNER: Betty Hoyle  
Rt. 2  
Caldwater, Mo.  
 (mailing address)

description of formations encountered	from	to
Red Clay	0	40
Red Sand	40	90
White Sand	90	135

WELL LOCATION:  
 sec. 8 T 5 N R 5 E  
2 1/2 miles NE of Thyatis  
 (distance) (direction) (nearest town)

WELL PURPOSE: Home  
 (home, irrigation, municipal, industrial)

WELL COMPLETION DATA:

(1) diameter (inches) 4

(2) total depth (feet) 135

(3) static water level (feet) 80 below above top of ground.

(4) casing PVC, 135  
 (material) (depth)

\_\_\_\_\_ if telescope see back.  
 (size)

(5) screen 7', 128  
4" (length) (depth to top)

\_\_\_\_\_ (size) \_\_\_\_\_ (material)  
gravel type

(6) pump 1/2 10  
 (HP) (yield gpm)

220V  
 (type power)

(7) electric log No  
 (yes or no)

\_\_\_\_\_ (organization running log)

(8) how well bottom plugged Cap

**RECEIVED**


AUG - 7 1978

DRILLERS REMARKS: \_\_\_\_\_

MISS. BD. OF WATER COMMISSIONERS

If well telescopes please sketch and show depths.

GROUND LEVEL

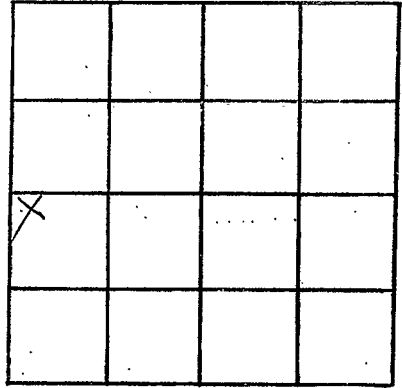

SECTION

8

Please indicate well location X.

ADDITIONAL INFORMATION

If more than one screen,  
show locations of each on sketch.