

TATE
J 2017
2/15/78

MISSISSIPPI
BOARD OF WATER COMMISSIONERS
416 North State Street
Jackson, Mississippi 39201

WATER WELL DRILLERS LOG

2-15-19 date well completed 78 Hicks Well Co. firm name Tate county well located

LANDOWNER: Dr. Edward Stewart
Pt. 2
Caldewater, Ms.
(mailing address)

WELL LOCATION:
sec. 7 T 5 N R 5 E
1 miles S of Beth
(distance) (direction) (nearest town)

WELL PURPOSE: Home
(home, irrigation, municipal, industrial)

WELL COMPLETION DATA:
(1) diameter (inches) 4
(2) total depth (feet) 140
(3) static water level (feet) 80 below top of ground.
(4) casing PVC 140 (material) (depth)
If telescope see back.
(5) screen 7' 133' (length) (depth to top)
4" gravel type (size) (material)
(6) pump 1/2 10 (HP) (yield gpm)
220V (type power)
(7) electric log No (yes or no)
(organization running log)
(8) how well bottom plugged Cap


description of formations encountered	from	to
Red Clay	0	30
Red Clay + Sand	30	60
Gravel	60	90
White Sand	90	120
White Sand + Clay	120	140

DRILLERS REMARKS:

RECEIVED
FEB 27 1978
MISS. BD. OF WATER COMM.

If well telescopes please sketch and show depths.

GROUND LEVEL

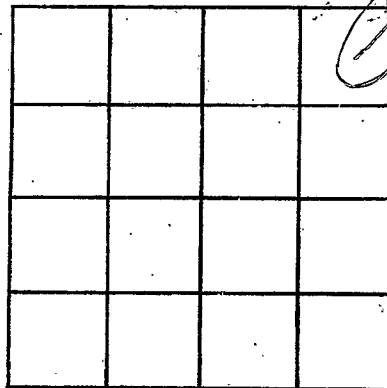

SECTION 7

Please indicate well location X.

ADDITIONAL INFORMATION

If more than one screen, show locations of each on sketch.