

TATE
J 2018
3-17-78

**MISSISSIPPI
BOARD OF WATER COMMISSIONERS**
416 North State Street
Jackson, Mississippi 39201

WATER WELL DRILLERS LOG

3-17-1978 Hick Well Co. Tate
 date well completed firm name county well located

LANDOWNER: Webber Steward
Rt. 5
Holly Springs, Mo. 38635
 (mailing address)

description of formations encountered	from	to
Red Clay	0	40
Red Sand	40	180
White Sand	180	228

WELL LOCATION:
 sec. 26 T 5 N R 5 E
1 miles S of Wynette
 (distance) (direction) (nearest town)

WELL PURPOSE: Drain
 (home, irrigation, municipal, industrial)

WELL COMPLETION DATA:

(1) diameter (inches) 4

(2) total depth (feet) 228

(3) static water level (feet) 200 below above top of ground.

(4) casing PVC, 228,
 (material) (depth)
 (size) if telescope see back.

(5) screen 21', 207
 (length) (depth to top)
4", gravel type
 (size) (material)

(6) pump 3 30
 (HP) (yield gpm)
220V
 (type power)

(7) electric log No
 (yes or no)

(organization running log)


(8) how well bottom plugged Cap

DRILLERS REMARKS:

RECEIVED
 MAY 1 - 1978
 MISS. Bd. OF WATER COMM.

If well telescopes please sketch and show depths.

GROUND LEVEL

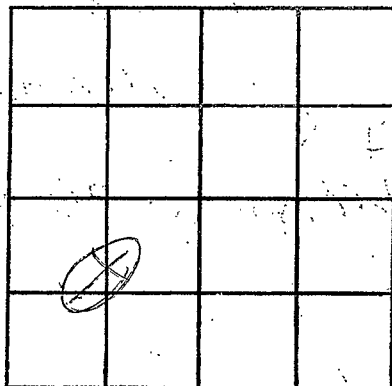

SECTION 26

Please indicate well location X.

ADDITIONAL INFORMATION

If more than one screen, show locations of each on sketch.