

TATE
 209 J
 3-28-78

MISSISSIPPI
 BOARD OF WATER COMMISSIONERS
 416 North State Street
 Jackson, Mississippi 39201

WATER WELL DRILLERS LOG

TATE
 Marshall

3-28-78 date well completed
 Hick Well Co firm name
 Marshall county well located

LANDOWNER: Alroydis Leggins
 Pt. 5
 Holly Springs, Ms.
 (mailing address)

description of formations encountered	from	to
Red Clay	0	15
Black Clay	15	65
Clay & Sand	65	190
White sand	190	235

WELL LOCATION:
 sec 25 T 5 N R 5 E
 2 1/2 miles SE of Wystle
 (distance) (direction) (nearest town)

WELL PURPOSE: Home
 (home, irrigation, municipal, industrial)

WELL COMPLETION DATA:

(1) diameter (inches) 4

(2) total depth (feet) 235

(3) static water level (feet) 165 below top of ground.

(4) casing PVC, 235,
 (material) (depth)
 (size) if telescope see back.

(5) screen 7', 228
 (length) (depth to top)
4", gravel type
 (size) (material)

(6) pump 3/4, 10
 (HP) (yield gpm)
220V
 (type power)

(7) electric log No
 (yes or no)

(organization running log)

(8) how well bottom plugged Cap


DRILLERS REMARKS:

RECEIVED
 MAY 1 - 1978

MISS. BD. OF WATER COMM

If well telescopes please sketch and show depths.

GROUND LEVEL

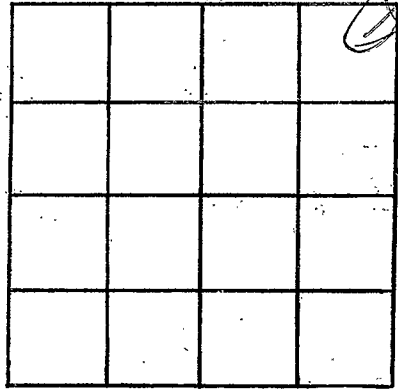

SECTION 25

Please indicate well location X.

ADDITIONAL INFORMATION

If more than one screen,
show locations of each on sketch.