


TATE
2020 J

**MISSISSIPPI
BOARD OF WATER COMMISSIONERS**
416 North State Street
Jackson, Mississippi 39201

WATER WELL DRILLERS LOG

5-9-19 78 High Well Co. Tate
 date well completed firm name county well located


LANDOWNER: <u>William Riker</u>	description of formations encountered	from	to
<u>Rt. 1</u>			
<u>Senatobia, Ms.</u> (mailing address)	<u>Red sand</u>	<u>15</u>	<u>120</u>
WELL LOCATION: sec <u>21</u> T. <u>5</u> N. R. <u>5</u> E <u>1 1/2</u> miles <u>SE</u> of <u>Thytua</u> (distance) (direction) (nearest town)	<u>White sand</u>	<u>120</u>	<u>167</u>
WELL PURPOSE: <u>Home</u> (home, irrigation, municipal, industrial)			
WELL COMPLETION DATA:			
(1) diameter (inches) <u>4"</u>			
(2) total depth (feet) <u>167'</u>			
(3) static water level (feet) <u>115</u> below above top of ground.			
(4) casing <u>PVC</u> , <u>167'</u> , (material) (depth)			
(size) if telescope see back.			
(5) screen <u>4'</u> , <u>163'</u> (length) (depth to top)			
<u>4"</u> , <u>gravel type</u> (size) (material)			
(6) pump <u>1/2</u> , <u>10</u> (HP) (yield gpm)			
<u>220V</u> (type power)			
(7) electric log <u>No</u> (yes or no)			
(organization running log)			
(8) how well bottom plugged <u>Cap</u>			
DRILLERS REMARKS:			

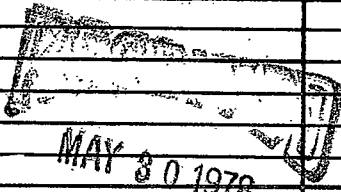

MISS. BD. OF WATER COMMISSIONERS

If well telescopes please sketch and show depths.

GROUND LEVEL

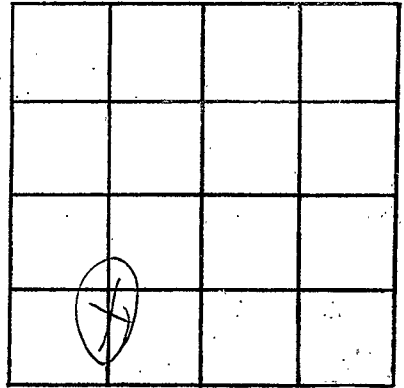

SECTION 21

Please indicate well location X.

ADDITIONAL INFORMATION

If more than one screen, show locations of each on sketch.