

TATE  
 2011 J  
 3-20-78

MISSISSIPPI  
 BOARD OF WATER COMMISSIONERS  
 416 North State Street  
 Jackson, Mississippi 39201

WATER WELL DRILLERS LOG

3-20 1978 Hickwell Co Tate  
 date well completed firm name county well located

LANDOWNER: Marylin Lippin  
Rt. 5  
Holly Springs, Ms.  
 (mailing address)

description of formations encountered	from	to
Red Clay	0	15
Black Clay	15	65
Clay + Sand	65	190
White Sand	190	235

WELL LOCATION:  
 sec 25 T 5 N R 5 E  
2 1/2 miles SE of Wynette  
 (distance) (direction) (nearest town)

WELL PURPOSE: Home  
 (home, irrigation, municipal, industrial)

WELL COMPLETION DATA:

(1) diameter (inches) 4"

(2) total depth (feet) 235

(3) static water level (feet) 165 below above top of ground.

(4) casing PVC, 235,  
 (material) (depth)  
 (size) If telescope see back.

(5) screen 7', 228  
 (length) (depth to top)  
4", gravel type  
 (size) (material)

(6) pump 3/4, 10  
 (HP) (yield gpm)  
220V  
 (type power)

(7) electric log No  
 (yes or no)

(organization running log)

(8) how well bottom plugged Cap


RECEIVED  
 NOV 13 1978

DRILLERS REMARKS:

MISS. BD. OF WATER COM.

If well telescopes please sketch and show depths.

GROUND LEVEL

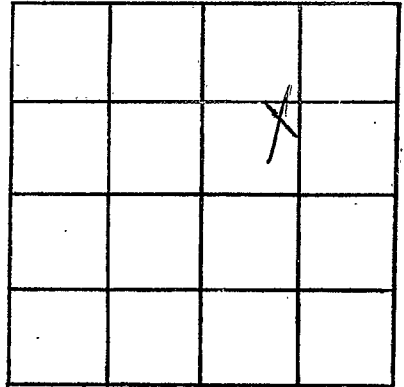

SECTION 25

Please indicate well location X.

ADDITIONAL INFORMATION

If more than one screen,  
show locations of each on sketch.