

TATE
J 2022
1-26-79

**MISSISSIPPI
BOARD OF WATER COMMISSIONERS**
416 North State Street
Jackson, Mississippi 39201

WATER WELL DRILLERS LOG

1-26-79 Hick Well Co Tate
 date well completed firm name county well located

~~LABORER:~~ Tate Co. Chandler
Chandler
Rt. 1, Senatobia, MS
 (mailing address)

description of formations encountered	from	to
Red Clay	0	10
Red Sand	10	65

WELL LOCATION:
 sec. 1 T 5 N R 5 E
2 miles NE of Wyatte
 (distance) (direction) (nearest town)

white clay + sand	65	95
-------------------	----	----

WELL PURPOSE:
 (home, irrigation, municipal, industrial)

Test Well for
Garbage Disposal

WELL COMPLETION DATA:

(1) diameter (inches) 4"

(2) total depth (feet) 95

(3) static water level (feet) _____ below
 top of ground. _____ above

(4) casing _____ (material) _____ (depth) _____
 _____ if telescope see back.
 (size) _____

(5) screen _____ (length) _____ (depth to top) _____
 (size) _____ (material) _____

(6) pump _____ (HP) _____ (yield gpm) _____
 (type power) _____

(7) electric log _____ (yes or no) _____
 (organization running log) _____

(8) how well bottom plugged _____


RECEIVED
 FEB 2 1979

DRILLERS REMARKS:

MISS. BD. OF WATER COMMISSIONERS

If well telescopes please sketch and show depths.

GROUND LEVEL

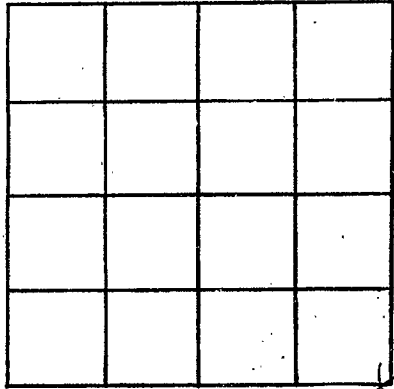

SECTION 1

Please indicate well location X.

ADDITIONAL INFORMATION

If more than one screen, show locations of each on sketch.