

TATE
J 2023

**MISSISSIPPI  
BOARD OF WATER COMMISSIONERS**  
416 North State Street  
Jackson, Mississippi 39201

**WATER WELL DRILLERS LOG**

5-15 1978 Hicks Well Co. Tate  
 date well completed                      firm name                      county well located

LANDOWNER: Mark Strick description of formations encountered

	from	to
<u>Red Clay</u>	<u>0</u>	<u>15</u>
<u>Red Sand</u>	<u>15</u>	<u>100</u>
<u>White Sand</u>	<u>100</u>	<u>145</u>

WELL LOCATION:  
 sec. 21 T. 5 N. R. 5 E.  
1 miles SE of Thytic  
 (distance) (direction) (nearest town)

WELL PURPOSE: Home  
 (home, irrigation, municipal, industrial)

WELL COMPLETION DATA:

(1) diameter (inches) 4

(2) total depth (feet) 145

(3) static water level (feet) 80 below above top of ground.

(4) casing PVC 145  
 (material) (depth)

\_\_\_\_\_ If telescope see back.  
 (size)

(5) screen 7' 141'  
 (length) (depth to top)  
4" gravel type  
 (size) (material)


(6) pump 1/2 10  
 (HP) (yield gpm)  
220V  
 (type power)

(7) electric log Y/N  
 (yes or no)

\_\_\_\_\_ (organization running log)

(8) how well bottom plugged Cap


DRILLERS REMARKS:  
 \_\_\_\_\_  
 \_\_\_\_\_

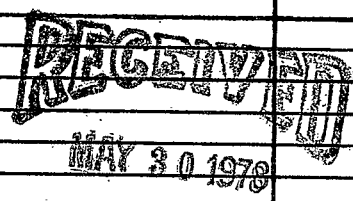

MISS. BD. OF WATER COMM.

If well telescopes please sketch and show depths.

GROUND LEVEL

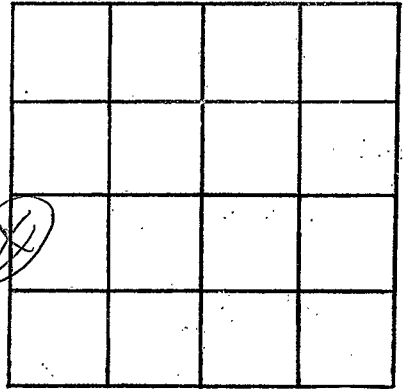

SECTION 21

Please indicate well location X.

ADDITIONAL INFORMATION

If more than one screen,  
show locations of each on sketch.