

TATE
 J 2004
 6/1/78

MISSISSIPPI
 BOARD OF WATER COMMISSIONERS
 416 North State Street
 Jackson, Mississippi 39201

WATER WELL DRILLERS LOG

6-1 1978 Hick Well Co Tate
 date well completed firm name county well located

LANDOWNER: Rocky Cosby
 Pt. 2
 Caldwellwater, Ms.
 (mailing address)


description of formations encountered	from	to
Red Clay	0	30
Red Clay + Sand	30	90

WELL LOCATION:
 sec. 6 T S N R 5 E W
 1 miles S of Beth
 (distance) (direction) (nearest town)

White Clay + Sand	90	135
White Sand	135	148

WELL PURPOSE: Home
 (home, irrigation, municipal, industrial)

WELL COMPLETION DATA:
 (1) diameter (inches) 4
 (2) total depth (feet) 148
 (3) static water level (feet) 88 below above top of ground.
 (4) casing PVC, 148.
 (material) (depth)
 (size) if telescope see back.
 (5) screen 7' 141
 (length) (depth to top)
 4" gravel type
 (size) (material)
 (6) pump 12 10
 (HP) (yield gpm)
 220V
 (type power)
 (7) electric log No
 (yes or no)
 (organization running log)
 (8) how well bottom plugged Cap

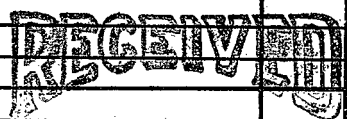


JUN 29 1978

DRILLERS REMARKS:
 MISS. BD. OF WATER COMMISSIONERS

If well telescopes please sketch and show depths.

GROUND LEVEL

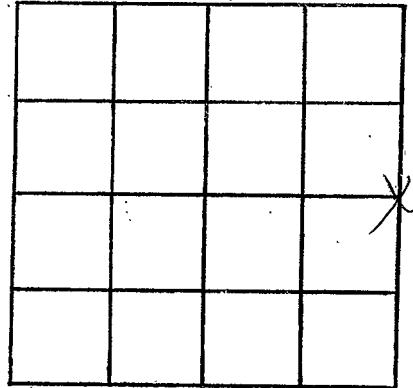

SECTION 6

Please indicate well location X.

ADDITIONAL INFORMATION

If more than one screen,
show locations of each on sketch.