

TATE
J
2025
10-5-78

**MISSISSIPPI  
BOARD OF WATER COMMISSIONERS**  
416 North State Street  
Jackson, Mississippi 39201

**WATER WELL DRILLERS LOG**

10-5-78 1978 Hicks Well Co Tate  
 date well completed      firm name      county well located

LANDOWNER: <u>Aubrey Buford</u> <u>Rt 2 Box 469</u> <u>Caldwater Ms. 38618</u> (mailing address)	description of formations encountered <u>Red Clay</u> <del><u>Red Clay + Sand</u></del>	from	to
		<u>0</u>	<u>40</u>

WELL LOCATION: sec. <u>7</u> T <u>5</u> N R <u>5</u> E <u>3</u> miles <u>N</u> of <u>Thyatira</u> (distance) (direction) (nearest town)	<u>White Clay</u> <u>80</u> <u>120</u> <u>White Sand</u> <u>120</u> <u>167</u>
--------------------------------------------------------------------------------------------------------------------------------------------------	-----------------------------------------------------------------------------------

WELL PURPOSE: Home  
 (home, irrigation, municipal, industrial)

WELL COMPLETION DATA:

(1) diameter (inches) 4

(2) total depth (feet) 167

(3) static water level (feet) 80 below top of ground.

(4) casing PVC 167  
       (material) (depth)

      (size) If telescope see back.

(5) screen 7 160  
       (length) (depth to top)

4 gravel type  
       (size) (material)

(6) pump 42 10  
       (HP) (yield gpm)


2000  
       (type power)

(7) electric log 76  
       (yes or no)

      (organization running log)


(8) how well bottom plugged Cap

DRILLERS REMARKS:

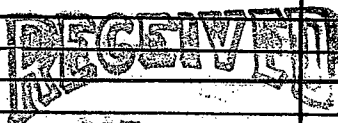

If well telescopes please  
sketch and show depths.

GROUND LEVEL

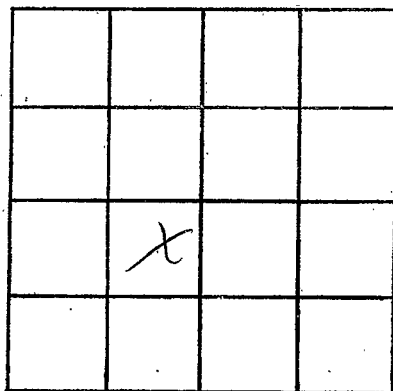

SECTION 7

Please indicate well location X.

ADDITIONAL INFORMATION

If more than one screen,  
show locations of each on sketch.