

Tate
 J 2026
 3-20-79

MISSISSIPPI
 BOARD OF WATER COMMISSIONERS
 416 North State Street
 Jackson, Mississippi 39201

WATER WELL DRILLERS LOG

3-20 1979
 date well completed

79 Hicks Well Co.
 firm name

Tate
 county well located

LANDOWNER:	description of formations encountered	from	to
Cloud Green Rt. 1, Senatobia Miss. (mailing address)	Red Clay	0	10
WELL LOCATION: sec. 31 T. 5 N. R. 5 E. 1 miles (distance) S of Senatobia (direction) (nearest town)	Red Sand	10	50
WELL PURPOSE: <u>Home</u> (home, irrigation, municipal, industrial)	Red Sand & Clay	50	105
WELL COMPLETION DATA:	White Sand	105	155
(1) diameter (inches) <u>4 in.</u>			
(2) total depth (feet) <u>155</u>			
(3) static water level (feet) <u>100</u> below top of ground.			
(4) casing <u>4 in.</u> (material) <u>155</u> (depth)			
(5) screen <u>7 ft</u> (length) <u>0.148</u> (depth to top)			
(6) pump <u>1/2</u> (HP) <u>10</u> (yield gpm)			
(7) electric log <u>No</u> (yes or no)			
(8) how well bottom plugged <u>COO</u>			
DRILLERS REMARKS:			


Miss. Board of Water Comm.

MAR 20 1979

RECEIVED

If well telescopes please sketch and show depths.

GROUND LEVEL

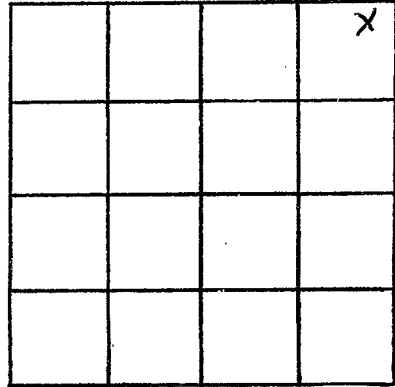

SECTION 31

Please indicate well location X.

ADDITIONAL INFORMATION

If more than one screen, show locations of each on sketch.