

TATE
 J 2031
 1-10-80

MISSISSIPPI
 BOARD OF WATER COMMISSIONERS
 416 North State Street
 Jackson, Mississippi 39201

CODED

WATER WELL DRILLERS LOG

1-10 date well completed 1980 Nichols Well Co firm name Tate county well located

LANDOWNER:
 George Raggia
 Rt. 1, Senatobia Miss.
 (mailing address)

description of formations encountered	from	to
	Red sand	0
Black clay	70	140
White sand	140	185

WELL LOCATION:
 sec. 5 N 5 E
 1/2 miles E of Bam
 (distance) (direction) (nearest town)

WELL PURPOSE: Home
 (home, irrigation, municipal, industrial)

- WELL COMPLETION DATA:
- (1) diameter (inches) 4 in
 - (2) total depth (feet) 185
 - (3) static water level (feet) 140 below top of ground.
 - (4) casing Plastic 140 (material) (depth)
 - (size) if telescope see back.
 - (5) screen 7 ft 133 (length) (depth to top)
 - 4 in. Iron pipe (size) (material)
 - (6) pump 1/2 10 (HP) (yield gpm)
 - 220 (type power)
 - (7) electric log No (yes or no)

(organization running log)
 (8) how well bottom plugged Cap

DRILLERS REMARKS:


DEPT. OF NATURAL RESOURCES
 BUREAU OF LAND & WATER RESOURCES

FEB 15 1980

RECEIVED

If well telescopes please sketch and show depths.

GROUND LEVEL

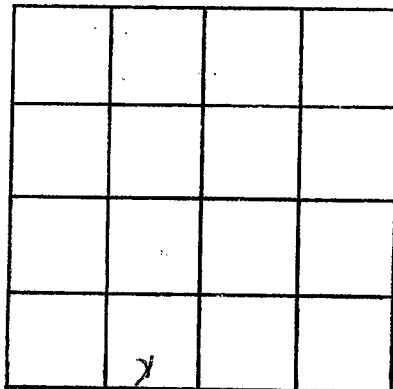

SECTION 19

Please indicate well location X.

ADDITIONAL INFORMATION

If more than one screen, show locations of each on sketch.