

TATE

MISSISSIPPI  
 BOARD OF WATER COMMISSIONERS  
 416 North State Street  
 Jackson, Mississippi 39201

J 2034  
 10-25-80  
 6-25-80

WATER WELL DRILLERS LOG

Dicks Well Co. Tate

date well completed

firm name

county well located

LANDOWNER:

Terry Phaw  
 Rt. 2 - Coldwater  
 (mailing address)

description of formations encountered

from

to

WELL LOCATION:  
 sec. 19 T. 5 N. R. 5 E  
 1 miles W of Thylas  
 (distance) (direction) (nearest town)

clay	0	30
red sand	30	90
white sand	90	170

WELL PURPOSE:

(home, irrigation, municipal, industrial)

home

WELL COMPLETION DATA:

- (1) diameter (inches) 4 in
- (2) total depth (feet) 170
- (3) static water level (feet) 130 below above top of ground
- (4) casing Plastic 170  
(material) (depth)
- (size) if telescope see back.
- (5) screen 7ft 163  
(length) (depth to top)  
4 in Gravel  
(size) (material)
- (6) pump 1/2 10  
(HP) (yield gpm)  
220  
(type power)
- (7) electric log No  
(yes or no)

(organization running log)

(8) how well bottom plugged Cap


DRILLERS REMARKS:

DEPT. OF NATURAL RESOURCES  
 BUREAU OF LAND & WATER RESOURCES

JUL 28 1980  
 RECEIVED

If well telescopes please sketch and show depths.

GROUND LEVEL

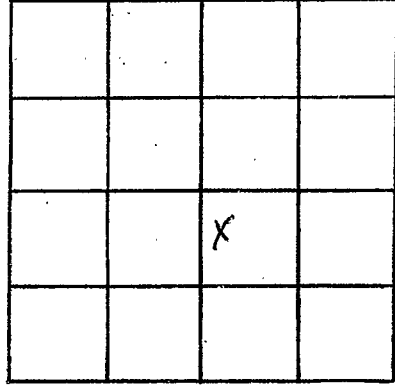

SECTION 19

Please indicate well location X.

ADDITIONAL INFORMATION

If more than one screen,  
show locations of each on sketch.