

TATE
 J 2030
 7-9-80

MISSISSIPPI
 BOARD OF WATER COMMISSIONERS
 416 North State Street
 Jackson, Mississippi 39201

WATER WELL DRILLERS LOG

7-9-80 19 date well completed
 J B Cain firm name
 Tate county well located

LANDOWNER: M G McRite
 Wynette Miss (mailing address)

description of formations encountered	from	to
Clay	0	8
Sand & Clay	8	80
Sand	80	160

WELL LOCATION:
 sec. 11 T. 5 N. R. 5 E. S. 1 W. 1
 1 1/2 miles EN of Wynette
 (distance) (direction) (nearest town)

WELL PURPOSE: Home
 (home, irrigation, municipal, industrial)

- WELL COMPLETION DATA:
- (1) diameter (inches) 4
 - (2) total depth (feet) 160
 - (3) static water level (feet) 130 (below/above top of ground)
 - (4) casing PVC 160 (material) (depth)
 - (size) if telescope see back.
 - (5) screen 10' 150 (length) (depth to top)
 - 4" PVC (size) (material)
 - (6) pump 3/4 10 (HP) (yield gpm)
 - Elect (type power)
 - (7) electric log (yes or no)

(organization running log)
 (8) how well bottom plugged Good Bottom

DRILLERS REMARKS:


DEPT. OF NATURAL RESOURCES
 BUREAU OF LAND & WATER RESOURCES

SEP 8 1980

RECEIVED

If well telescopes please sketch and show depths.

GROUND LEVEL

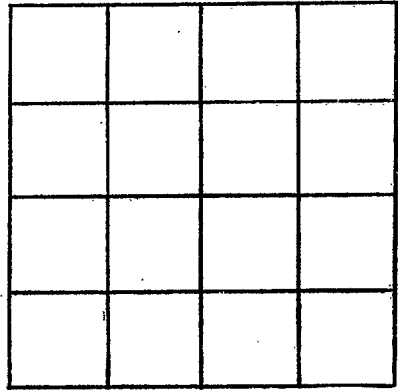

SECTION _____

Please indicate well location X.

ADDITIONAL INFORMATION

If more than one screen, show locations of each on sketch.