

Tate  
 J 2037  
 8-6-80

MISSISSIPPI  
 BOARD OF WATER COMMISSIONERS  
 416 North State Street  
 Jackson, Mississippi 39201

WATER WELL DRILLERS LOG

8-6 19 80 date well completed  
 High Well Co. firm name  
 Tate county well located

LANDOWNER: <u>Danny Tersley</u> <u>Rt. 1</u>	description of formations encountered	from	to
<u>Senatobia, Ms.</u> (mailing address)	<u>Clay</u>	<u>0</u>	<u>30</u>
WELL LOCATION: sec. <u>33</u> T <u>5</u> N R <u>5</u> E <u>1</u> miles <u>S</u> of <u>High</u> (distance) (direction) (nearest town)	<u>Sand</u>	<u>30</u>	<u>120</u>
WELL PURPOSE: <u>Home</u> (home, irrigation, municipal, industrial)	<u>White Sand</u>	<u>120</u>	<u>170</u>
WELL COMPLETION DATA:			
(1) diameter (inches) <u>4"</u>			
(2) total depth (feet) <u>170</u>			
(3) static water level (feet) <u>130</u> below above top of ground.			
(4) casing <u>PVC</u> <u>170</u> (material) (depth)			
(size) If telescope see back.			
(5) screen <u>7</u> <u>163</u> (length) (depth to top)			
<u>4"</u> <u>gravel type</u> (size) (material)			
(6) pump <u>1/2</u> <u>10</u> (HP) (yield gpm)			
<u>220V</u> (type power)			
(7) electric log <u>No</u> (yes or no)			
(organization running log)			
(8) how well bottom plugged <u>Cap</u>			
DRILLERS REMARKS:			


DEPT. OF NATURAL RESOURCES  
 BUREAU OF LAND & WATER RESOURCES

SEP 26 1980

RECEIVED

If well telescopes please sketch and show depths.

GROUND LEVEL

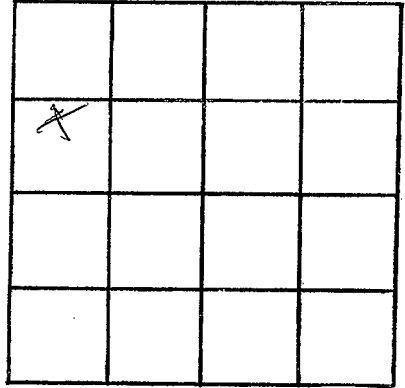

SECTION 33

Please indicate well location X.

ADDITIONAL INFORMATION

If more than one screen,  
show locations of each on sketch.