

Tate
J 2038
8-9-80

MISSISSIPPI
BOARD OF WATER COMMISSIONERS
416 North State Street
Jackson, Mississippi 39201

WATER WELL DRILLERS LOG

8-9-80 date well completed Hich Well Co firm name Tate county well located

LANDOWNER: <u>Hary Vespy</u> <u>City</u>	description of formations encountered	from	to
<u>Senatobia, Mo.</u> (mailing address)	<u>Clay</u>	<u>0</u>	<u>30</u>
	<u>White Sand</u>	<u>30</u>	<u>125</u>

WELL LOCATION:
sec 20 T 5 N R 5 E
S W
_____ miles of Thyers
(distance) (direction) (nearest town)

WELL PURPOSE: Home
(home, irrigation, municipal, industrial)


- WELL COMPLETION DATA:
- (1) diameter (inches) 4
 - (2) total depth (feet) 125
 - (3) static water level (feet) 90 below above top of ground.
 - (4) casing PVC, 125,
(material) (depth)
_____ If telescope see back.
(size)
 - (5) screen 7', 118
(length) (depth to top)
4", gravel type
(size) (material)
 - (6) pump 1/2, 10
(HP) (yield gpm)
220V
(type power)
 - (7) electric log No
(yes or no)
 - _____ (organization running log)
 - (8) how well bottom plugged Cap

DRILLERS REMARKS:

STATE OF MISSISSIPPI
BUREAU OF LAND & WATER
SEP 26 1980
RECEIVED

If well telescopes please sketch and show depths.

GROUND LEVEL

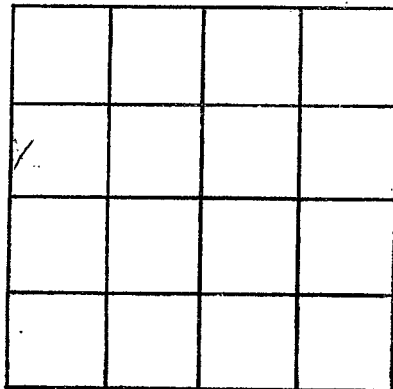

SECTION 503

Please indicate well location X.

ADDITIONAL INFORMATION

If more than one screen, show locations of each on sketch.