

Tate
 J 2039
 8-25-80

MISSISSIPPI
 BOARD OF WATER COMMISSIONERS
 416 North State Street
 Jackson, Mississippi 39201

WATER WELL DRILLERS LOG

8-25-1980 High Well Co Teton
 date well completed firm name county well located

LANDOWNER: Robert Collins
 Rt. 1
 Senatobia, Ms.
 (mailing address)

description of formations encountered	from	to
Clay	0	30
Sand	30	140

WELL LOCATION:
 sec 20 T 8 N R 5 E
 1 1/2 miles S of Ripper
 (distance) (direction) (nearest town)

White Sand	140	194
------------	-----	-----

WELL PURPOSE: Home
 (home, irrigation, municipal, industrial)

- WELL COMPLETION DATA:
- (1) diameter (inches) 4
 - (2) total depth (feet) 194
 - (3) static water level (feet) 120 below top of ground.
 - (4) casing PVC, 194 (material) (depth)
 - (size) if telescope see back.
 - (5) screen 7 (length), 187 (depth to top)
 - 4" gravel type (size) (material)
 - (6) pump 1/2 (HP), 10 (yield gpm)
 - 220V (type power)
 - (7) electric log No (yes or no)
 - (organization running log)
 - (8) how well bottom plugged Cap

DEPT. OF NATURAL RESOURCES
 BUREAU OF LAND & WATER RESOURCES


SEP 29 1980

RECEIVED

DRILLERS REMARKS:

If well telescopes please sketch and show depths.

GROUND LEVEL

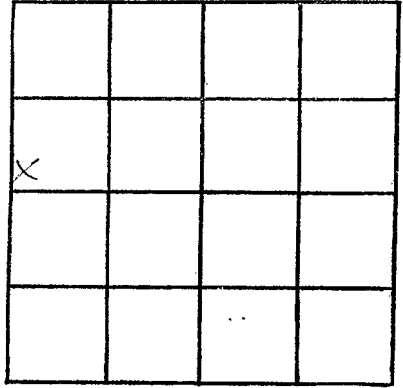

SECTION 33

Please indicate well location X.

ADDITIONAL INFORMATION

If more than one screen, show locations of each on sketch.