

TATE
 J 2040
 9-16-80

MISSISSIPPI
 BOARD OF WATER COMMISSIONERS
 416 North State Street
 Jackson, Mississippi 39201

WATER WELL DRILLERS LOG

9-16 1980 date well completed Dick's Well Co. firm name Tate county well located

LANDOWNER: Raymond Patrick Rt. 5	description of formations encountered	from	to
Holley Linnis Mrs. (mailing address)	Red Clay	0	20
WELL LOCATION: sec. 20 T. 5 N. R. 5 E. (distance) (direction) (nearest town)	White Sand	20	125
WELL PURPOSE: Home (home, irrigation, municipal, industrial)			
WELL COMPLETION DATA:			
(1) diameter (inches) 4			
(2) total depth (feet) 125			
(3) static water level (feet) 60 below top of ground.			
(4) casing PVC 125 (material) (depth)			
(size) if telescope see back.			
(5) screen 17' 118 (length) (depth to top)			
4" gravel type (size) (material)			
(6) pump 1/2 10 (HP) (yield gpm)			
220V (type power)			
(7) electric log No (yes or no)			
(organization running log)			
(8) how well bottom plugged Cap			
DRILLERS REMARKS:			


DEPT. OF NATURAL RESOURCES
 BUREAU OF LAND & WATER RESOURCES

SEP 29 1980

RECEIVED

If well telescopes please sketch and show depths.

GROUND LEVEL

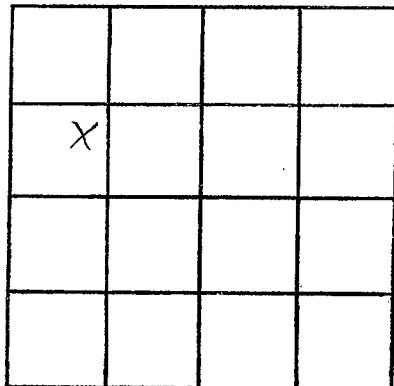

SECTION 20

Please indicate well location X.

ADDITIONAL INFORMATION

If more than one screen,
show locations of each on sketch.