

Tate
 2041
 4-17-80

MISSISSIPPI
 BOARD OF WATER COMMISSIONERS
 416 North State Street
 Jackson, Mississippi 39201

WATER WELL DRILLERS LOG

date well completed

firm name

county well located

1980 Richs Well Co Marshall

LANDOWNER:

Sylvester Wilkins
 Rt. 3, Holly Springs
 (mailing address)

description of formations encountered

from

to

clay	0	30
red sand	30	140
white sand	140	230

WELL LOCATION:

sec. 7 T. 3 N. R. 3 E
 Salena Miss.
 (distance) miles (direction) of (nearest town)

WELL PURPOSE:

(home, irrigation, municipal, industrial)

WELL COMPLETION DATA:

- (1) diameter (inches) 4 in
- (2) total depth (feet) 230
- (3) static water level (feet) 190 below top of ground.
- (4) casing Plastic 230
 (material) (depth)
- (size) If telescope see back.
- (5) screen 223
 (length) (depth to top)
4 in brass
 (size) (material)
- (6) pump 3/4 10
 (HP) (yield gpm)
220
 (type power)
- (7) electric log No
 (yes or no)

(organization running log)

well bottom plugged cap

MARKS:


DEPT. OF NATURAL RESOURCES
 BUREAU OF LAND & WATER RESOURCES

APR 20 1980

RECEIVED

If well telescopes please sketch and show depths.

GROUND LEVEL

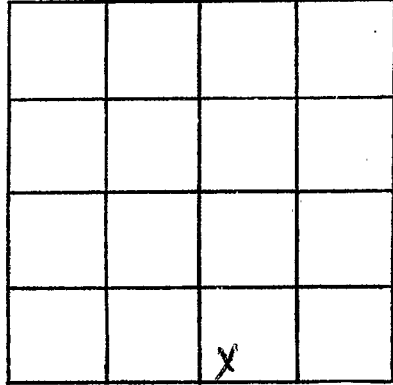

SECTION 7

Please indicate well location X.

ADDITIONAL INFORMATION

If more than one screen,
show locations of each on sketch.