

MISSISSIPPI DEPARTMENT OF NATURAL RESOURCES

Bureau of Land and Water Resources

Southport Mall

P.O. Box 10631

Jackson, Mississippi 39209

WATER WELL DRILLERS LOG

TATE
J 2042
12-31-80

12-31 1980

Hicks Well Co

Tates

date well completed

firm name

county well located

LANDOWNER: Dr. the Stager

Rt. 1

Senatobia, Ms.

(mailing address)

description of formations encountered

from

to

Red sand

0

70

Black clay

70

140

white sand

140

180

WELL LOCATION:

sec. 19 T 5 N R 5 E
(S) (W)
1/2 miles W of Theriot
(distance) (direction) (nearest town)

WELL PURPOSE: Home
(home, irrigation, municipal, industrial)

WELL COMPLETION DATA:

- (1) diameter (inches) 4
- (2) total depth (feet) 180
- (3) static water level (feet) 110 below above top of ground.
- (4) casing PVC 180
(material) (depth)
- (size) If telescope see back.
- (5) screen 12 168
(length) (depth to top)
- 80 81
(size) (material)
- (6) pump 1 10
(HP) (yield gpm)
- 220
(type power)
- (7) electric log No
(yes or no)

(organization running log)

(8) how well bottom plugged Cap

DRILLERS REMARKS:


DEPT. OF NATURAL RESOURCES
BUREAU OF LAND & WATER RESOURCES

JAN 12 1981

RECEIVED

If well telescopes please sketch and show depths.

GROUND LEVEL

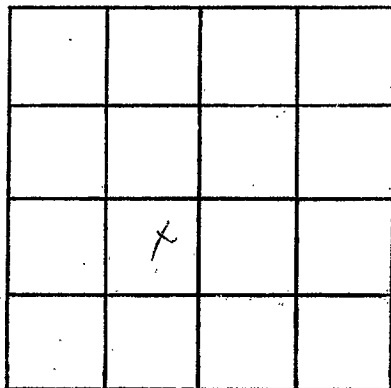

SECTION 19

Please indicate well location X.

ADDITIONAL INFORMATION

If more than one screen, show locations of each on sketch.