

MISSISSIPPI DEPARTMENT OF NATURAL RESOURCES

Bureau of Land and Water Resources

Southport Mall

P.O. Box 10631

Jackson, Mississippi 39209

WATER WELL DRILLERS LOG

TATE
J 2043
1-30-81

1-30-81 date well completed 1981 firm name Hicks Well Co. county well located Tate


LANDOWNER: <u>Melvin Frasier</u> <u>Rt. 1</u>	description of formations encountered	from	to
<u>Senatobia, Ms.</u> (mailing address)	<u>Red Sand</u>	<u>0</u>	<u>100</u>
WELL LOCATION: sec. <u>22</u> T <u>5</u> N R <u>5</u> E <u>1</u> miles <u>W</u> of <u>Wyatts</u> (distance) (direction) (nearest town)	<u>White Sand</u>	<u>100</u>	<u>195</u>
WELL PURPOSE: <u>Home</u> (home, irrigation, municipal, industrial)			
WELL COMPLETION DATA:			
(1) diameter (inches) <u>4</u>			
(2) total depth (feet) <u>195</u>			
(3) static water level (feet) <u>150</u> below top of ground.			
(4) casing <u>PVC</u> <u>195</u> (material) (depth)			
<u> </u> if telescope see back. (size)			
(5) screen <u>12</u> <u>183</u> (length) (depth to top)			
<u>4"</u> <u>gravel</u> (size) (material)			
(6) pump <u>1/2</u> <u>10</u> (HP) (yield gpm)			
<u>720V</u> (type power)			
(7) electric log <u>No</u> (yes or no)			
<u> </u> (organization running log)			
(8) how well bottom plugged <u>Cup</u>			

DRILLERS REMARKS:

DEPT. OF NATURAL RESOURCES
BUREAU OF LAND & WATER RESOURCES
FEB 12 1981
RECEIVED

If well telescopes please sketch and show depths.

GROUND LEVEL

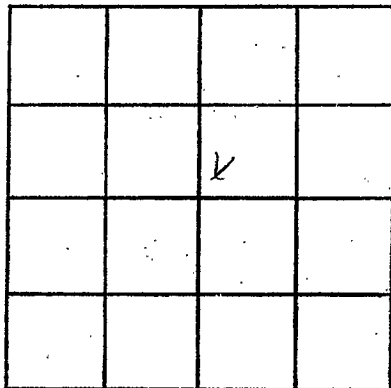

SECTION 22

Please indicate well location X.

ADDITIONAL INFORMATION

If more than one screen, show locations of each on sketch.