

MISSISSIPPI DEPARTMENT OF NATURAL RESOURCES

Bureau of Land and Water Resources

Southport Mall

P.O. Box 10631


Jackson, Mississippi 39209

WATER WELL DRILLERS LOG

TATE
J 2044
4-14-81

24-124 1981 Hicks Well Co. Tate
 date well completed firm name county well located


LANDOWNER: <u>George Hicks</u> <u>Rt. 1 Box 157</u>	description of formations encountered	from	to
<u>Senatobia, Mo. 38668</u> (mailing address)	<u>Red Clay</u>	<u>0</u>	<u>10</u>
WELL LOCATION: sec. <u>23</u> <u>5</u> N R <u>5</u> E <u>1/2</u> miles <u>W</u> of <u>Wyatts</u> (distance) (direction) (nearest town)	<u>Red sand</u>	<u>10</u>	<u>50</u>
WELL PURPOSE: <u>farm</u> (home, irrigation, municipal, industrial)	<u>White sand</u>	<u>50</u>	<u>200</u>
WELL COMPLETION DATA: (1) diameter (inches) <u>4</u> (2) total depth (feet) <u>200</u> (3) static water level (feet) <u>100</u> below above top of ground. (4) casing <u>PVC</u> <u>200</u> (material) (depth) (size) if telescope see back. (5) screen <u>12</u> <u>188</u> (length) (depth to top) <u>4"</u> <u>gravel + slotted</u> (size) (material) (6) pump <u>1 1/2</u> <u>18</u> (HP) (yield gpm) <u>2200</u> (type power) (7) electric log <u>No</u> (yes or no) (organization running log) (8) how well bottom plugged <u>Cup</u>			

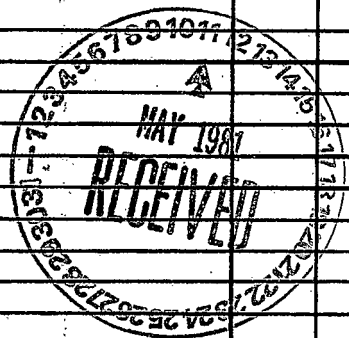

DRILLERS REMARKS:

If well telescopes please sketch and show depths.

GROUND LEVEL

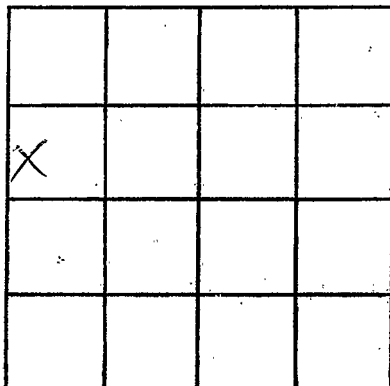

SECTION 23

Please indicate well location X.

ADDITIONAL INFORMATION

If more than one screen, show locations of each on sketch.