

MISSISSIPPI DEPARTMENT OF NATURAL RESOURCES

Bureau of Land and Water Resources

Southport Mall

P.O. Box 10631


Jackson, Mississippi 39209

WATER WELL DRILLERS LOG

TATE
J 2046
7-17-81


7-17 1981 Hicks Well Co. Tate
date well completed firm name county well located

LANDOWNER:	description of formations encountered	from	to
William Davis Rt. 2	Red Clay	0	35
Caldwate, W.M. (mailing address)	White Clay	35	50
WELL LOCATION: sec. 18 T. 5 N. R. 5 E. 2 miles N of Thorton (distance) (direction) (nearest town)	White Sand	50	90
WELL PURPOSE: Well Field (home, irrigation, municipal, industrial)	White clay	90	100
WELL COMPLETION DATA: (1) diameter (inches) 4	White Sand	100	140
(2) total depth (feet) 140			
(3) static water level (feet) 90 below above top of ground.			
(4) casing PVC, 140 (material), (depth)			
(size) If telescope see back.			
(5) screen 7, 133 (length), (depth to top)			
2" gravel type (size), (material)			
(6) pump 1/2, 10 (HP), (yield gpm)			
220V (type power)			
(7) electric log Yes (yes or no)			
(organization running log)			
(8) how well bottom plugged Cap			
DRILLERS REMARKS:			

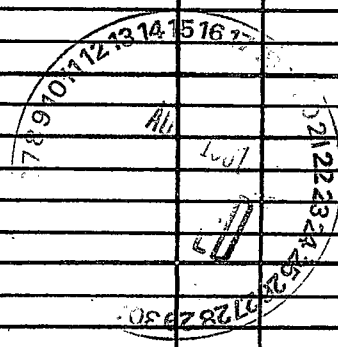

If well telescopes please sketch and show depths.

GROUND LEVEL

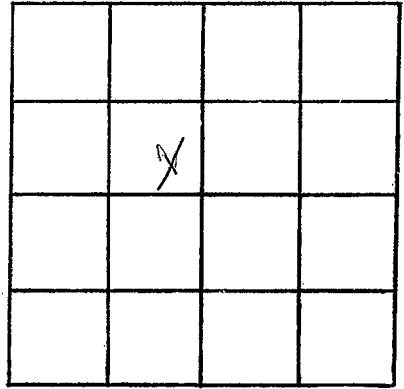

SECTION 18

Please indicate well location X.

ADDITIONAL INFORMATION

A series of horizontal lines for writing additional information.

If more than one screen, show locations of each on sketch.