

MISSISSIPPI DEPARTMENT OF NATURAL RESOURCES

Bureau of Land and Water Resources

Southport Mall

P.O. Box 10631

Jackson, Mississippi 39209

WATER WELL DRILLERS LOG

HICKS WELL COMPANY

Tate
J 2048
10-23-81

10-23 1981 date well completed RT 1 BOX 157 firm name SENATOBIA, MISS county well located Tate

LANDOWNER: Max Anderson
P.O. Box 130 AA
Senatobia, Ms. 38668
(mailing address)

description of formations encountered	from	to
Red Clay	0	20
Red Sand	20	170
White Sand	170	220

WELL LOCATION:
sec. 33 T 5 N R 5 E
1/2 miles N of Tye.
(distance) (direction) (nearest town)

WELL PURPOSE: Home
(home, irrigation, municipal, industrial)

WELL COMPLETION DATA:

- (1) diameter (inches) 4
- (2) total depth (feet) 220
- (3) static water level (feet) 180 below above top of ground.
- (4) casing PVC, 220 (material), (depth)
- (size) if telescope see back.
- (5) screen 12, 208 (length), (depth to top)
- 4" gravel + PVC (size), (material)
- (6) pump 3/4, 10 (HP), (yield gpm)
- 220V (type power)
- (7) electric log No (yes or no)
- (organization running log)

(8) how well bottom plugged Cap

DRILLERS REMARKS:


DEPT. OF NATURAL RESOURCES
BUREAU OF LAND & WATER RESOURCES

NOV 9 - 1981

RECEIVED

If well telescopes please sketch and show depths.

GROUND LEVEL

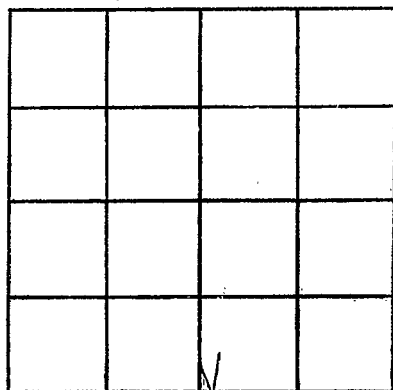

SECTION 33

Please indicate well location X.

ADDITIONAL INFORMATION

If more than one screen,
show locations of each on sketch.