

MISSISSIPPI DEPARTMENT OF NATURAL RESOURCES

Bureau of Land and Water Resources

Southport Mall

P.O. Box 10631

Jackson, Mississippi 39209

WATER WELL DRILLERS LOG

TATE
J 2050
12/8/81

Tate

12-8 1981 HICKS WELL COMPANY
 date well completed 1 - BOX # 157 name

county well located

LANDOWNER: *Wick Moore Jr.*

MISS. description of formations encountered	from	to

Rt. 2
~~Caldwell~~ Ms. 38618
 (mailing address)

Red Clay	0	20
----------	---	----

WELL LOCATION:

sec. 4 T. 5 N. R. 5 E.
 3 miles SW of *Beth*
 (distance) (direction) (nearest town)

Clay + Sand	20	80
-------------	----	----

WELL PURPOSE: *Home*
 (home, irrigation, municipal, industrial)

Red Sand	80	95
----------	----	----

WELL COMPLETION DATA:

(1) diameter (inches) 4
 (2) total depth (feet) 125
 (3) static water level (feet) 100 below above top of ground.

White Sand	95	125
------------	----	-----

(4) casing PVC 125
 (material) (depth)
 (size) if telescope see back.

(5) screen 9 116
 (length) (depth to top)
4" gravel + PVC
 (size) (material)

(6) pump 1/2 10
 (HP) (yield gpm)
220V
 (type power)

(7) electric log No
 (yes or no)
 (organization running log)

(8) how well bottom plugged Cap

DRILLERS REMARKS:


DEPT. OF NATURAL RESOURCES
 BUREAU OF LAND & WATER RESOURCES

JAN 4 1982

RECEIVED

If well telescopes please sketch and show depths.

GROUND LEVEL

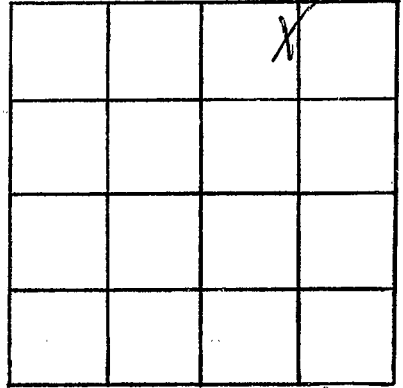

SECTION 4

Please indicate well location X.

ADDITIONAL INFORMATION

If more than one screen,
show locations of each on sketch.