

MISSISSIPPI DEPARTMENT OF NATURAL RESOURCES

Bureau of Land and Water Resources

Southport Mall

P.O. Box 10631

Jackson, Mississippi 39209

WATER WELL DRILLERS LOG

Date 7/20/82

6-15-82 HICKS WELL COMPANY

Tate

date well completed

RT. 1 - BOX 157

county well located

LANDOWNER: Joan Hurdle

SENATOBIA, MISS.

description of formations encountered

from

to

D.V. 1
Senatobia, Miss. 38668
(mailing address)

Red clay	0	10
Red sand	10	65
white sand	65	125
Black clay	125	160
white sand	160	200

WELL LOCATION:

sec. 19 T. 5 N. R. 5 E.
1 miles W of Thytua
(distance) (direction) (nearest town)

WELL PURPOSE: Home
(home, irrigation, municipal, industrial)

WELL COMPLETION DATA:

- (1) diameter (inches) 4
- (2) total depth (feet) 200
- (3) static water level (feet) 140 below above top of ground.
- (4) casing PVC, 200
(material) (depth)
4" if telescope see back.
(size)
- (5) screen 18', 190
(length) (depth to top)
0.10, PVC
(size) (material)
- (6) pump 1/2, 10
(HP) (yield gpm)
220V
(type power)
- (7) electric log No
(yes or no)

(organization running log)

(8) how well bottom plugged Cap

DEPT. OF NATURAL RESOURCES
BUREAU OF LAND & WATER RESOURCES


JUL - 6 1982

DRILLERS REMARKS:

RECEIVED

If well telescopes please
sketch and show depths.

GROUND LEVEL

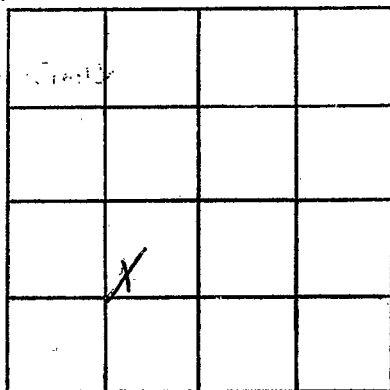

SECTION 19

Please indicate well location X.

ADDITIONAL INFORMATION

If more than one screen,
show locations of each on sketch.