

MISSISSIPPI DEPARTMENT OF NATURAL RESOURCES

Bureau of Land and Water Resources

Southport Mall

P.O. Box 10631

Jackson, Mississippi 39209

WATER WELL DRILLERS LOG

HICKS WELL COMPANY

Date
 J
 2052

6-28 19 82 RT. 1 BOX 157
 date well completed firm name

SENATORIA MISS county well located

LANDOWNER: Raymond Patrick

description of formations encountered from to

Rt. 3

Haley Springs, Miss.
 (mailing address)

Red Clay 0 20

Red Sand 20 55

WELL LOCATION:

sec. 21 T. 5 N R. 5 E
 1 miles E of Thytia
 (distance) (direction) (nearest town)

Blue Clay & White Sand 55 80

White Sand 80 100

WELL PURPOSE: Home
 (home, irrigation, municipal, industrial)

Rock 100 101

WELL COMPLETION DATA:

White Sand 101 170

(1) diameter (inches) 4

(2) total depth (feet) 170

(3) static water level (feet) 80 below top of ground.

(4) casing PVC 170
 (material) (depth)

4
 (size) if telescope see back.

(5) screen 9' 163
 (length) (depth to top)

02 PVC
 (size) (material)

(6) pump 1/2 10
 (HP) (yield gpm)

220V
 (type power)

(7) electric log No
 (yes or no)

(organization running log)

(8) how well bottom plugged Cap

DEPT. OF NATURAL RESOURCES
 BUREAU OF LAND & WATER RESOURCES


JUL - 6 1982

RECEIVED

DRILLERS REMARKS:

If well telescopes please sketch and show depths.

GROUND LEVEL

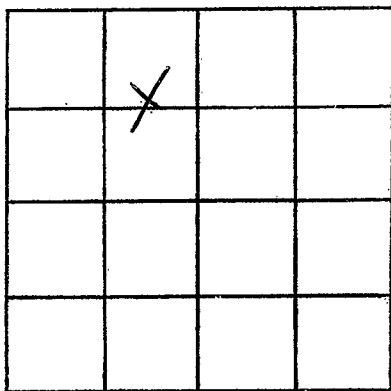

SECTION 21

Please indicate well location X.

ADDITIONAL INFORMATION

If more than one screen,
show locations of each on sketch.