

MISSISSIPPI DEPARTMENT OF NATURAL RESOURCES

Bureau of Land and Water Resources

Southport Mall

P.O. Box 10631

Jackson, Mississippi 39209

WATER WELL DRILLERS LOG

Date
 9
 2053

Date

9-28 1982
 date well completed

HICKS WELL CO.
 Rt. 1, Box 157
 Senatobia, MS 38668

county well located

LANDOWNER: George Hicks
Rt. 1 Box 157
Senatobia, Miss.
 (mailing address) 38668

description of formations encountered	from	to
	Red Clay	0
Red Sand	20	50

WELL LOCATION:
 sec. 11 T 5 N R. 5 E
1 1/2 miles N of Wynette
 (distance) (direction) (nearest town)

White sand	50	95
Rock	95	96

WELL PURPOSE: Farm
 (home, irrigation, municipal, industrial)

White Sand	96	125
------------	----	-----

WELL COMPLETION DATA:

White clay	125	145
------------	-----	-----

- (1) diameter (inches) 4
- (2) total depth (feet) 192
- (3) static water level (feet) 160 ^{below} above top of ground.
- (4) casing PVC, 192
 (material) (depth)
4"
 (size) if telescope see back.
- (5) screen 19, 173
 (length) (depth to top)
.02, gravel & PVC
 (size) (material)
- (6) pump 1/2, 10
 (HP) (yield gpm)
220V
 (type power)
- (7) electric log No
 (yes or no)

White sand	145	192
------------	-----	-----

(organization running log)

(8) how well bottom plugged Cap


DRILLERS REMARKS:

DEPT. OF NATURAL RESOURCES
 BUREAU OF LAND & WATER RESOURCES

OCT 14 1982
 RECEIVED

If well telescopes please sketch and show depths.

GROUND LEVEL

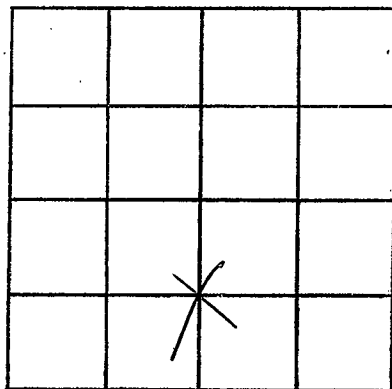

SECTION 11

Please indicate well location X.

ADDITIONAL INFORMATION

If more than one screen, show locations of each on sketch.